

Survey Monument Record

TYPE OF MONUMENT 3/4" x 24" IRON
BAR SET W/ CAP


CORNER NO. 25
 SECTION 02
 TOWN 3N
 RANGE 3W

FIELD BOOK: 96-01
 PAGE (22)

BASIS FOR MONUMENT LOCATION

(Use reverse side if necessary)


Show info such as: History of corner, with reference to Vol. and pg., dates, surveyor; exact description of monument replaced; if location computed, by taped or EDM traverse; landowner, remarks, etc.

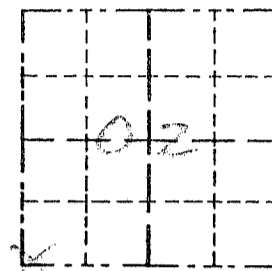

LOCATION
 (Indicated by "X")

SEAL:

CORNER SET IN 1833 BY ROBERT CLARK. NO RECORD OF CORNER FOUND SINCE ORIGINAL SURVEYS I SET THE CORNER AT AN OCCUPIED LOCATION. VERIFIED THIS LOCATION USING EDM METHODS.

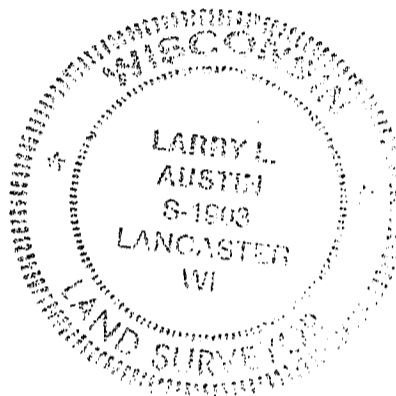

CERTIFIED CORRECT

Larry L. Austin
 Registered Land Surveyor

DATE: 12-20-97

TIE SKETCH

Show at least three (3) ties and monument

LEGEND

- 3/4" x 24" IRON BAR W/ ALUM. CAP.
- 1/2" x 15" IRON BAR
- XX EXISTING FENCE

