U.S. PUBLIC LAND SURVEY MONUMENT RECORD - GRANT COUNTY, WI

Section 32, Town 3 North Range 3 West, Town of Potosi

CERTIFICATE

I, Larry L. Austin, do hereby certify that the corner location on this record was determined by me and/or under my direct supervision and that this U.S. public land survey monument record is correct and complete to the best of my knowledge and belief.

Dated this 5th day of Novemter, 2001

Larry L. Austin S-1903

WISCONSIN
LARRY L. AUSTIN S-1903 LANCASTER WI
LAND SURVEYOR

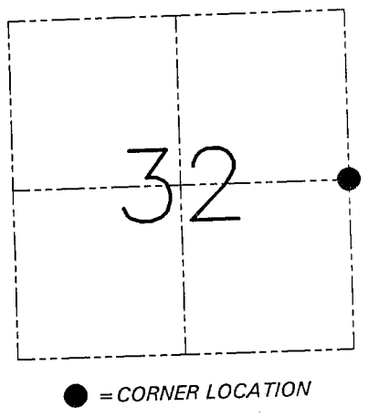

HISTORY OF CORNER ESTABLISHMENT

Corner was originally set in 1833 by Robert Clark. In 1840 Freeman tied to the corner. No other record of the corner was found.

DESCRIPTION OF CORNER EVIDENCE FOUND

I found no evidence to the location of the corner. I reset the corner proportionately between the Northeast and Southeast corners of Section 32. Verified this location using EDM & GPS methods.

DESCRIPTION OF CORNER AND WITNESS MONUMENTS, *references and accessories used to perpetuate the original or re-established location of this corner. Witnesses to the corner location Bobby Sedgwick & Shelby Blindert*

SKETCH:

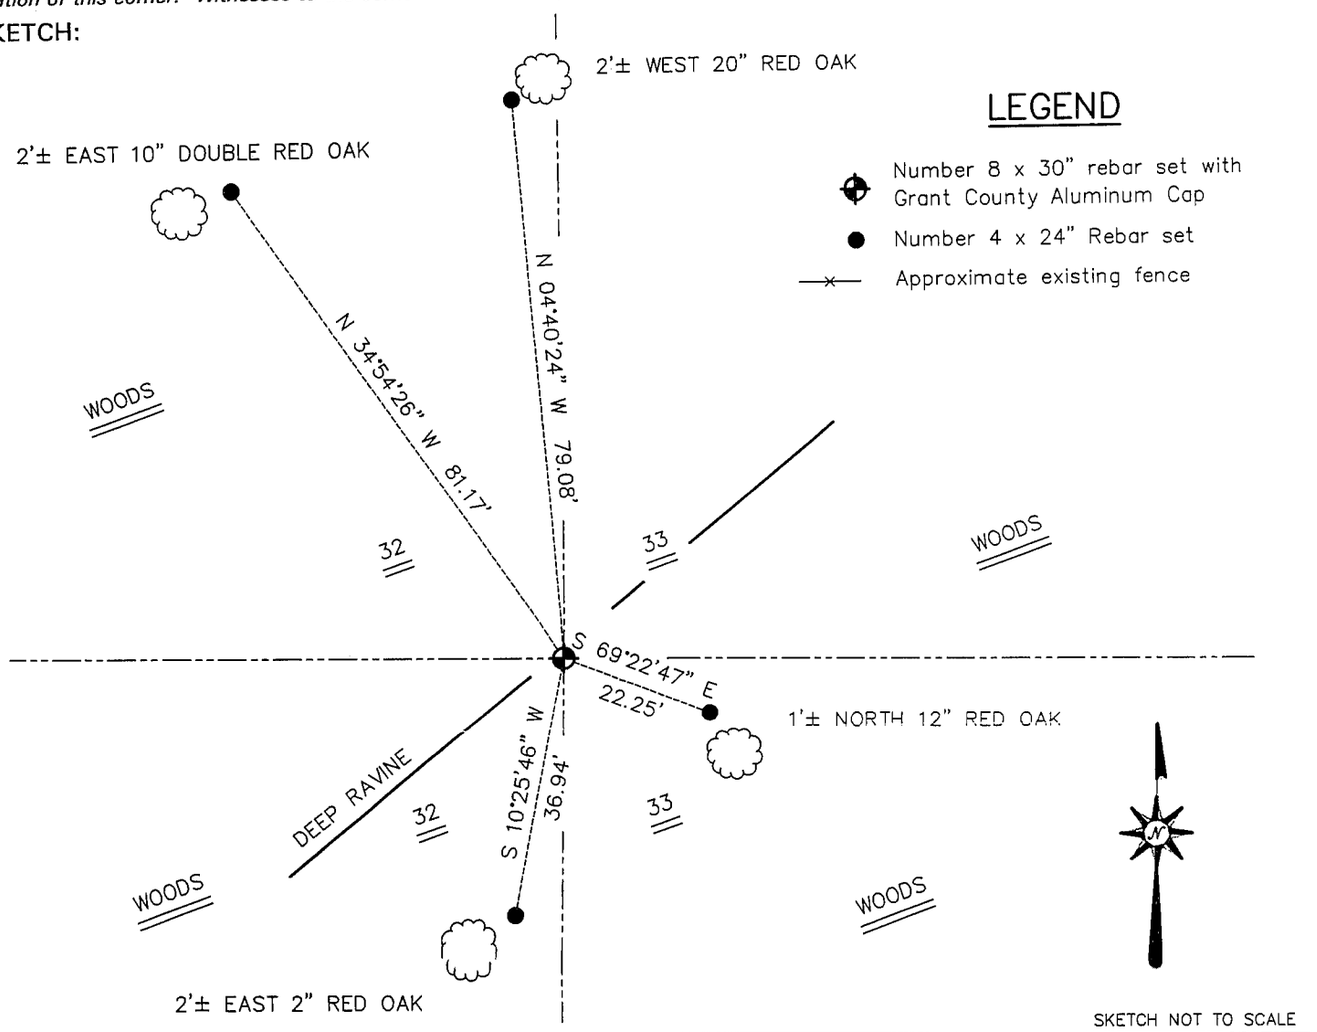

AUSTIN ENGINEERING, LLC

4211 HWY 81 EAST, LANCASTER, WI 53813
PHONE 608-723-6363 FAX 608-723-6702

FIELDBOOK: SDR33, 2040
G:\T3NR3W\29
C:\SWA\TIE\T3NR3W\116
CREW: BS-SB-SA

DRAWN BY: SW AUSTIN
APPROVED: LL AUSTIN

CORNER NUMBER 116