SEP 24 1981

SURVEY DATA

Sec. 21
T3N
R3W Potosi Twp.

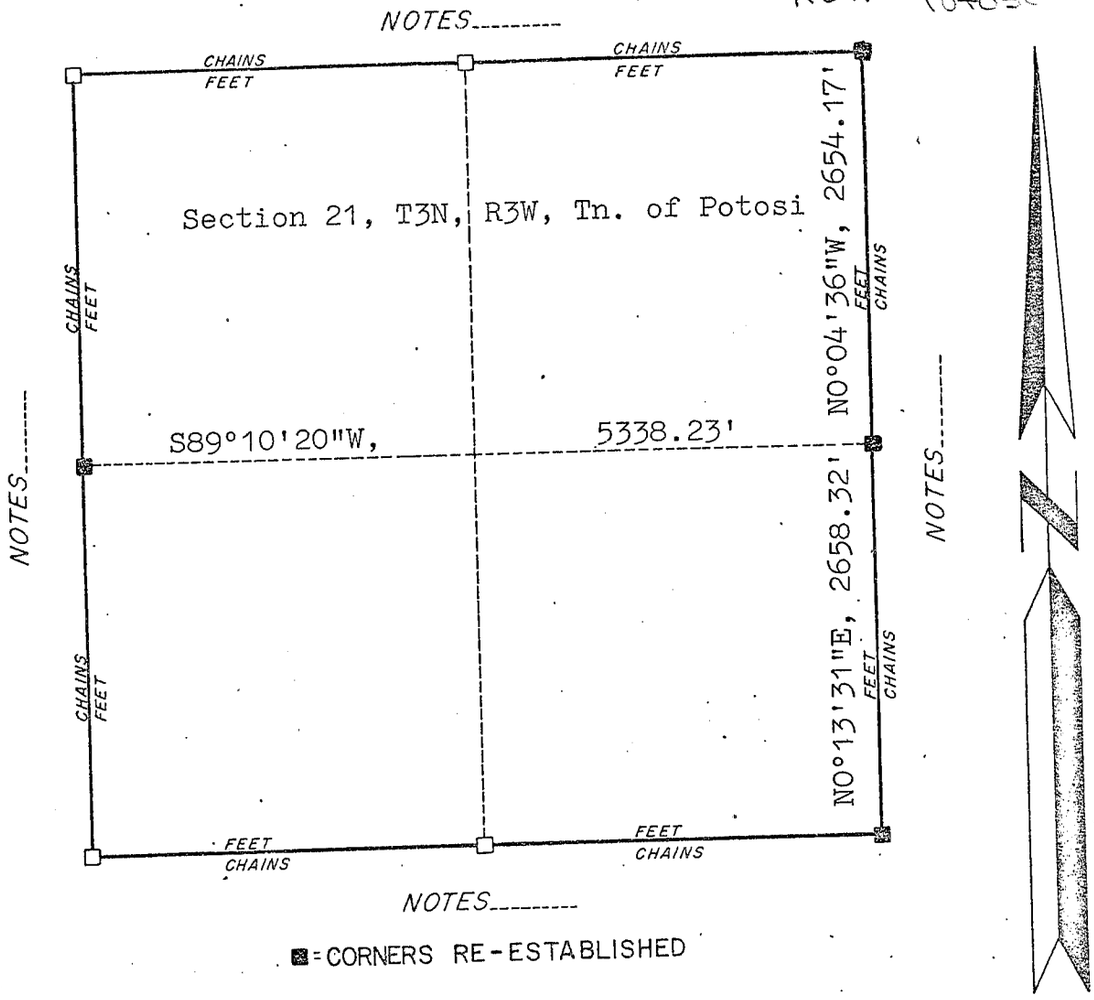

-Bearing system used: * Assumed North *

RE-SURVEY DATA

SECTION 21 TOWNSHIP 3 NORTH RANGE 3 WEST

SURVEYED BY: David A. Davis, RLS DATE Dec. 1980, Jan. 1981

CONTRACT DATE:

COUNTY: Grant

TOWN - ~~VILLAGE CITY~~ of Potosi

David A. Davis 9-22-81

SOUTHWEST ENGINEERING, INC.
206 S. Iowa Street
DODGEVILLE, WIS. 53533

- SURVEYORS SEAL -

WISCONSIN
DAVID A. DAVIS
S-1498
BLUE MOUNDS WIS.
LAND SURVEYOR

PAGE ____ OF ____