34057.5

U.S. PUBLIC LAND SURVEY MONUMENT RECORD - GRANT COUNTY, WI

Section 15, Town 3 North Range 4 West, Town of Waterloo (a)

NOTE: This form is intended and designed to fulfill all requirements of the Wisconsin Administrative Code Chapter A-E 7.08, U.S. Public Land Survey Monument Record (3) (a) (b) (c) (d) (e) (f) (g) (h) (i).

CERTIFICATE: (i)
I, Aaron J. Austin, Wisconsin Professional Land Surveyor, do hereby certify that the corner location on this record was determined by me and/or under my direct supervision and that this U.S. Public Land Survey Monument Record is correct and complete to the best of my knowledge and belief.

Dated this 20th day of October, 2025.

Aaron J. Austin

Aaron J. Austin, S-2922

WISCONSIN AARON J. AUSTIN S-2922 LANCASTER WI LAND SURVEYOR

Grant County Coordinates:
NAD 83 (2011)
Northing: 481,912.23
Easting: 786,876.75

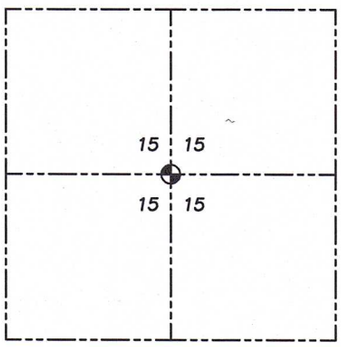

=CORNER LOCATION

HISTORY OF CORNER ESTABLISHMENT:

Corner was not set with the Original Government Survey.
Joel Barber established the corner on a survey filed in Book D, Page 6 dated 1-9-1877.
Larry Austin set a 3/4" Rebar on a Plat of Survey filed in Book 8, Page 59 dated 12-20-2000.

DESCRIPTION OF CORNER EVIDENCE FOUND: (b) (f) (g) (h)

I found the 3/4" Rebar Larry set. I established four witness corners and verified the Monument's location with G.P.S. and E.D.M. methods.

DESCRIPTION OF CORNER AND WITNESS MONUMENTS, references and accessories used to perpetuate the original or re-established location of this corner. (c) (d) (e)
Witnesses to corner location Owen Austin, Tanner Austin.
Drawn by: Owen Austin.

SKETCH:

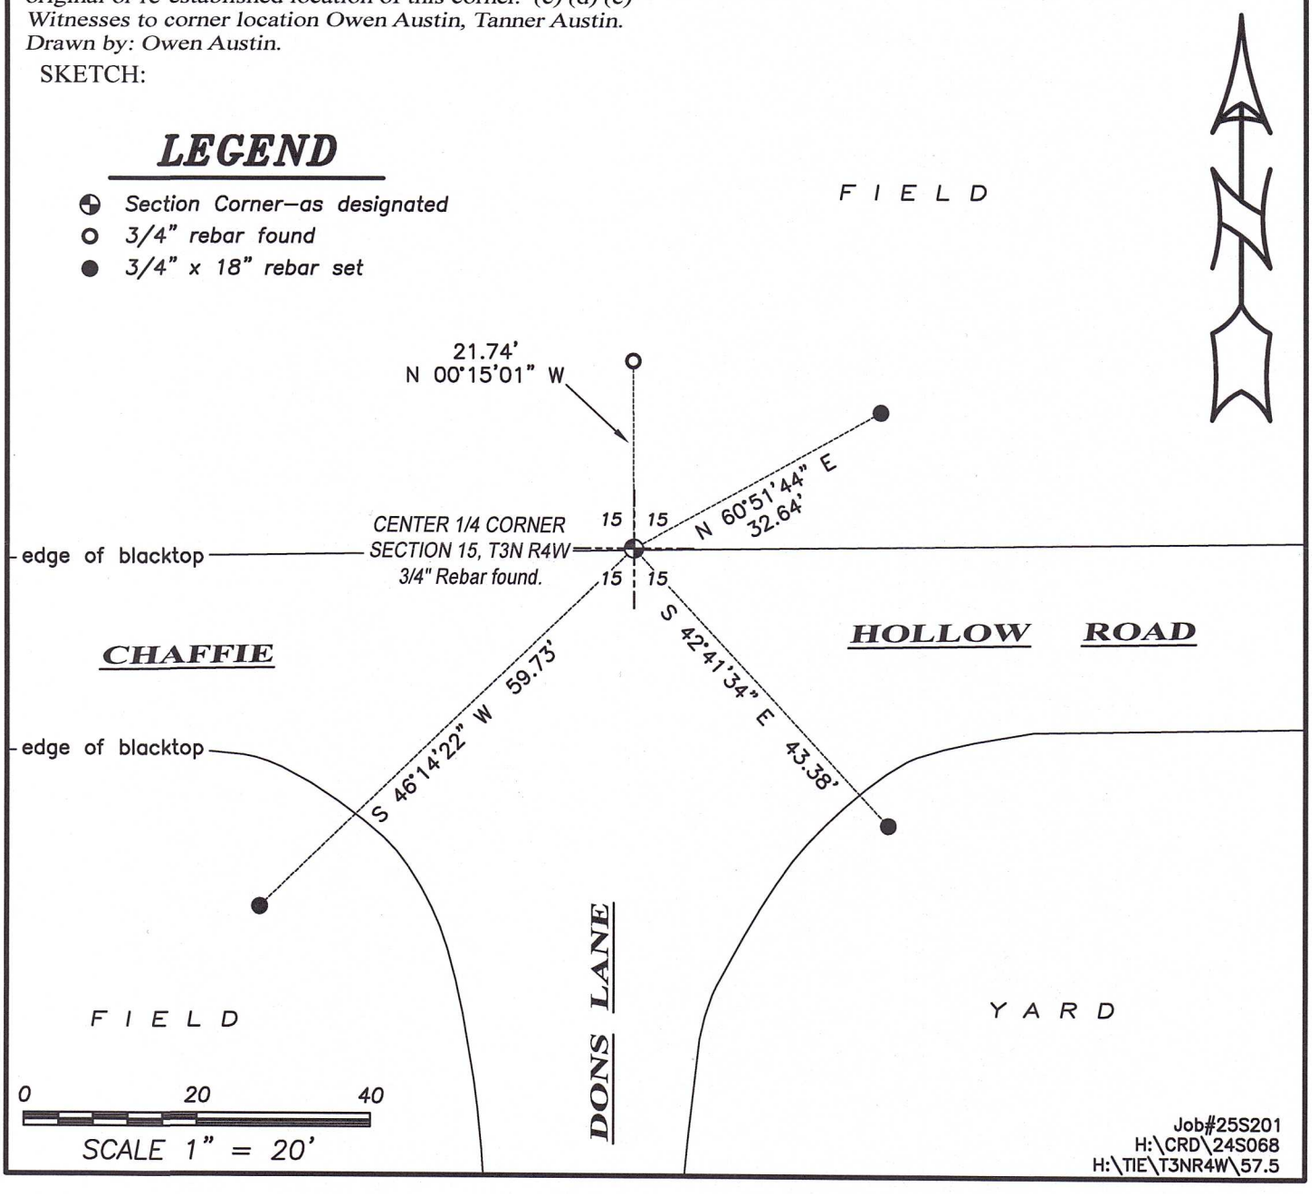

Job#25S201
H:\CRD\24S068
H:\TIE\T3NR4W\57.5