35011

U.S. PUBLIC LAND SURVEY MONUMENT RECORD - GRANT COUNTY, WI

Section 6, Town 3 North Range 5 West, Town of Cassville (a)

NOTE: This form is intended and designed to fulfill all requirements of the Wisconsin Administrative Code Chapter A-E 7.08, U.S. Public Land Survey Monument Record (3) (a) (b) (c) (d) (e) (f) (g) (h) (i).

CERTIFICATE: (i)
I, Aaron J. Austin, Wisconsin Professional Land Surveyor, do hereby certify that the corner location on this record was determined by me and/or under my direct supervision and that this U.S. Public Land Survey Monument Record is correct and complete to the best of my knowledge and belief.

Dated this 25th day of May, 2022

Aaron J Austin

Aaron J. Austin, S-2922

WISCONSIN AARON J. AUSTIN S 2922 LANCASTER WI LAND SURVEYOR

Grant County Coordinates:
NAD 83 (2011)
Northing: 495,807.80
Easting: 741,966.53

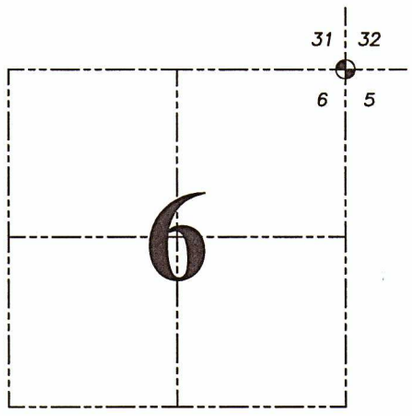

HISTORY OF CORNER ESTABLISHMENT:

Original corner was set in 1832 by Lucius Lyon.
G.J Overton found the original corner on a Survey filed in Book B, Page 514 dated 10/23/1856.
No other record of this corner was found.

DESCRIPTION OF CORNER EVIDENCE FOUND: (b) (f) (g) (h)

I found and accepted a fence corner that matches extremely well with the occupational South line of the North 15 acres as called for in Document Number 453294. I set four witness corners after I verified the Monument's location with G.P.S. and E.D.M. methods.

DESCRIPTION OF CORNER AND WITNESS MONUMENTS, references and accessories used to perpetuate the original or re-established location of this corner. (c) (d) (e)
Witnesses to corner location Shane Austin, Owen Austin.
Drawn by Owen Austin

SKETCH:

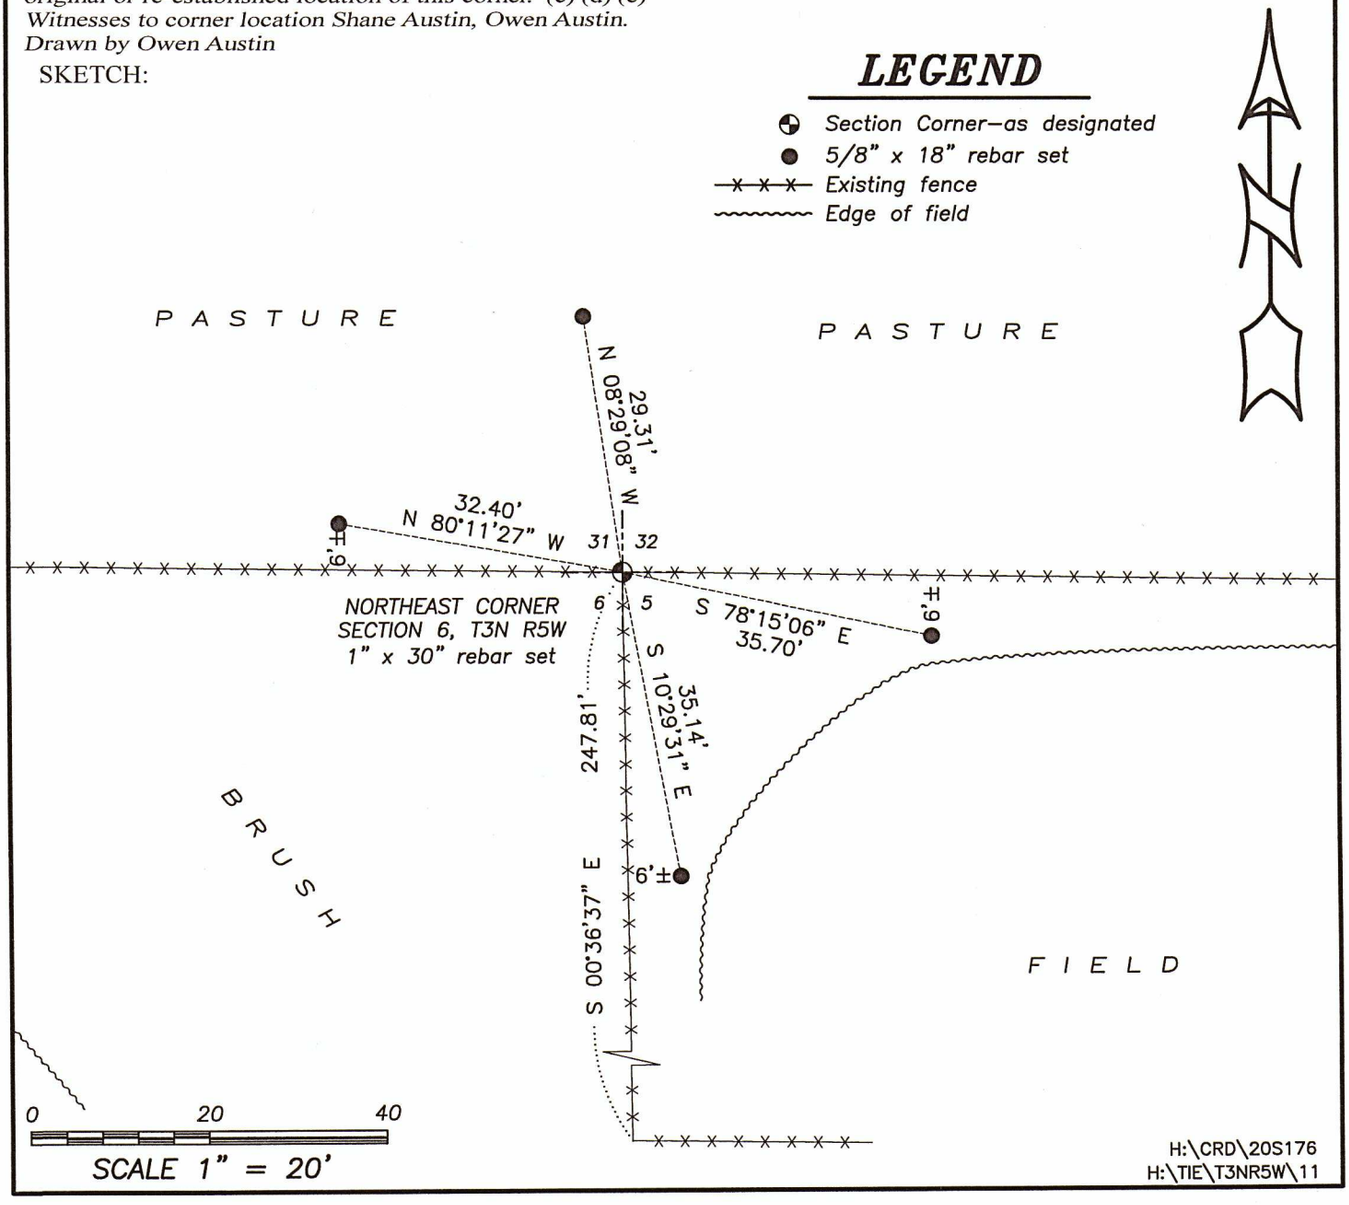

H:\CRD\20S176
H:\TIE\T3NR5W\11