35032

U.S. PUBLIC LAND SURVEY MONUMENT RECORD - GRANT COUNTY, WI

Section 6, Town 3 North Range 5 West, Town of Cassville (a)

NOTE: This form is intended and designed to fulfill all requirements of the Wisconsin Administrative Code Chapter A-E 7.08, U.S. Public Land Survey Monument Record (3) (a) (b) (c) (d) (e) (f) (g) (h) (i).

CERTIFICATE: (i)
I, Aaron J. Austin, Wisconsin Professional Land Surveyor, do hereby certify that the corner location on this record was determined by me and/or under my direct supervision and that this U.S. Public Land Survey Monument Record is correct and complete to the best of my knowledge and belief.

Dated this 31st day of March, 2022.

Aaron J Austin

Aaron J. Austin, S-2922

WISCONSIN AARON J. AUSTIN S-2922 LANCASTER WI LAND SURVEYOR

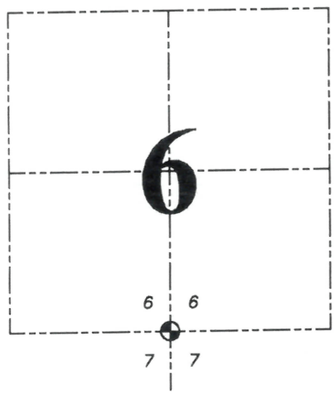

Grant County Coordinates:
NAD 83 (2011)
Northing: 490,544.16
Easting: 739,343.98

HISTORY OF CORNER ESTABLISHMENT:

Original corner was set in 1832 by Lucius Lyon.
Original corner was found on a Survey filed in Book C, Page 144 dated 1/1/1858.
Chris Higgins set a 3/4" Rebar at the Corner on a Survey filed in Book 32, Page 61 dated 11-12-2012.

DESCRIPTION OF CORNER EVIDENCE FOUND: (b) (f) (g) (h)

Higgins Rebar could not be found after extensive surveying in Sections 6 and 7 of T3N, R5W and Section 1 of T3N, R6W. I did not accept Higgins location. I reestablished the Corner using Higgins Northing of Book 32, Page 61 and set a 7/8" x 24" Rebar Midway between the Southeast and Southwest Corners of Section 6. I set four witness corners after I verified the Monument's location with G.P.S. and E.D.M. methods.

DESCRIPTION OF CORNER AND WITNESS MONUMENTS, references and accessories used to perpetuate the original or re-established location of this corner. (c) (d) (e)
Witnesses to corner location Shane Austin, Owen Austin.
Drawn by Owen Austin

SKETCH:

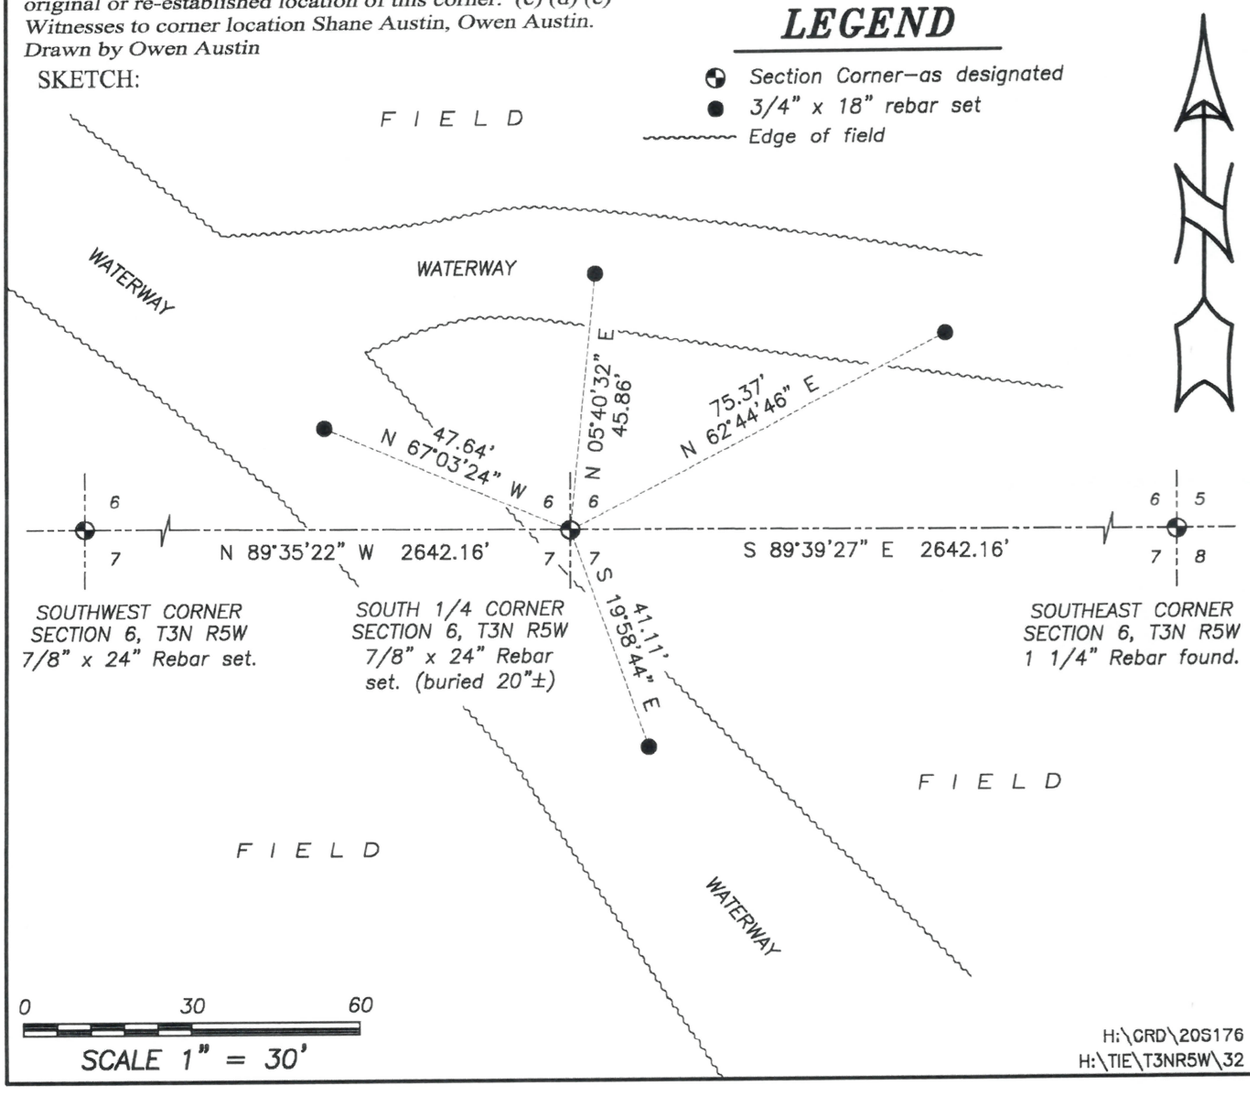

H:\CRD\20S176
H:\TIE\T3NR5W\32