(5)

SECTION CORNER TIE SHEET INDEX
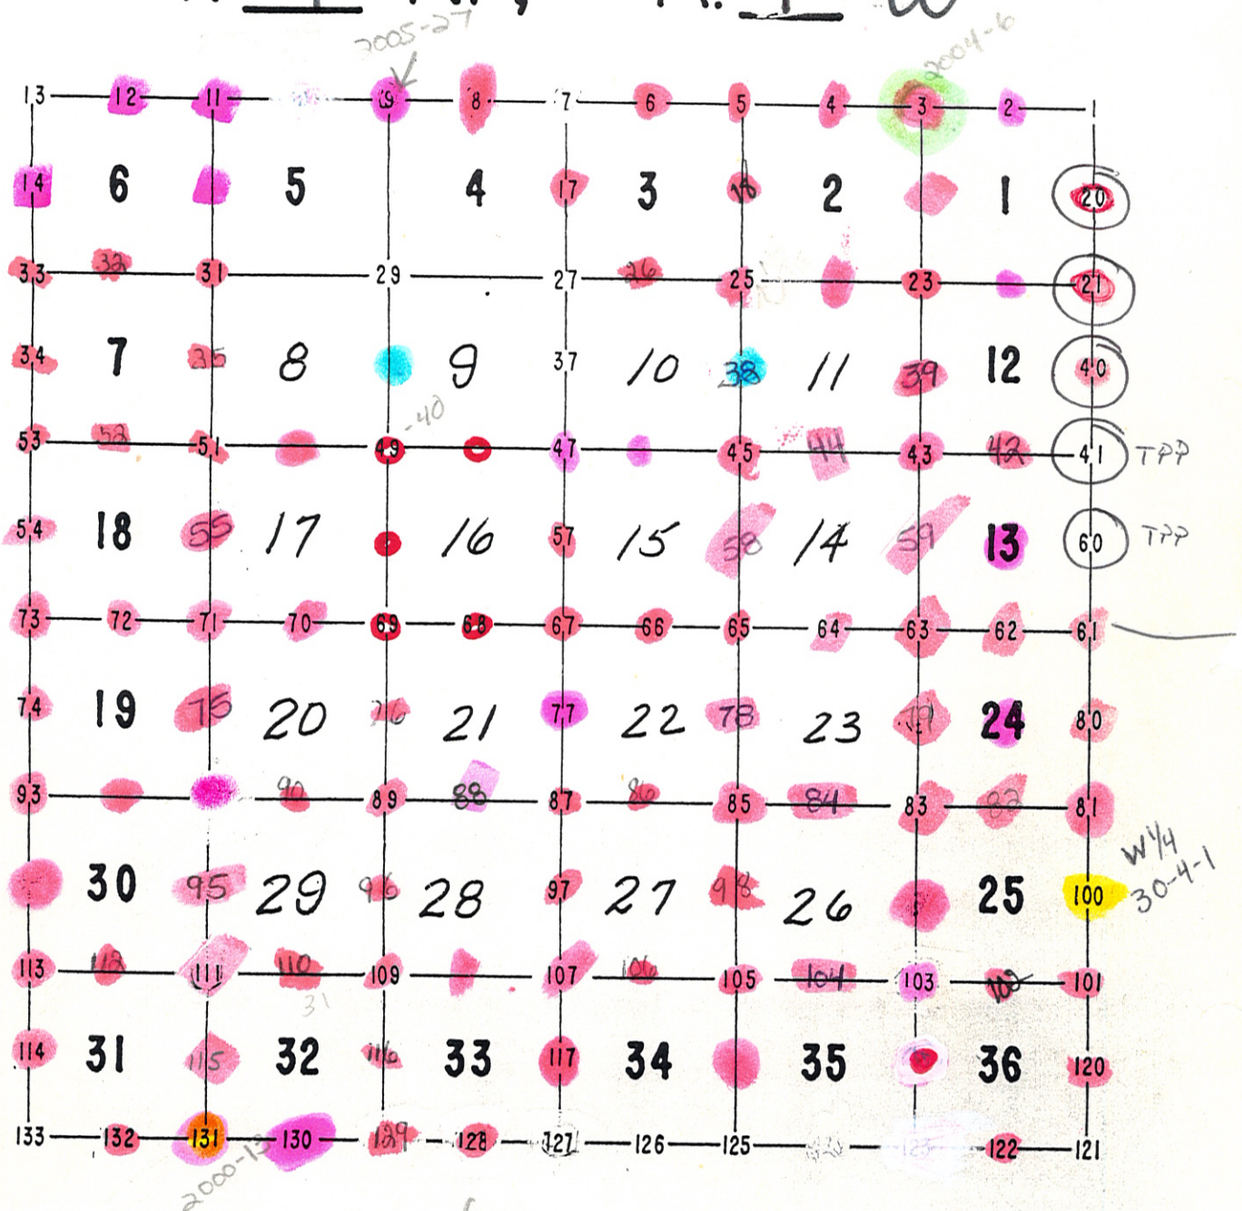
T. 4 N., R. 1 W