


Survey Monument Record

TYPE OF MONUMENT 3/4" X 24" IRON
BAR SET

CORNER NO. 80
 SECTION 24
 TOWN 4N
 RANGE 21W

FIELD BOOK: 96-22(A)
 PAGE (26)

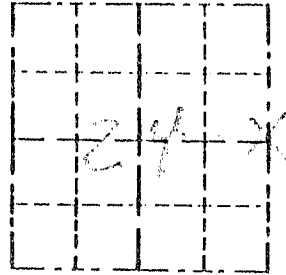

BASIS FOR MONUMENT LOCATION


(Use reverse side if necessary)

Show info such as: History of corner, with reference to Vol and pg, dates, surveyor; exact description of monument replaced; if location computed, by taped or EDM traverse; landowner, remarks, etc.

CORNER SET IN 1832 BY SIBLEY. NO RECORD OF CORNER FOUND SINCE ORIGINAL SURVEYS; CORNER SET AT RECORDED OFFSET FROM OCCUPATION AT THE WEST 1/4 CORNER OF SEC. 19 T4N R1W. VERIFIED THIS LOCATION USING EDM METHODS.

LOCATION
 (Indicated by "X")

SEAL:

 

CERTIFIED CORRECT

Kary L. Aust
 Registered Land Surveyor

DATE: 12-14-97

TIE SKETCH

Show at least three (3) ties and monument

LEGEND

- ⊙ 3/4" X 24" IRON BAR SET
- 1/2" X 15" IRON BAR SET
- XX EXISTING FENCE

