GRANT COUNTY

Section Summary

4 - T4N - R4W

SECTION - TOWN - RANGE

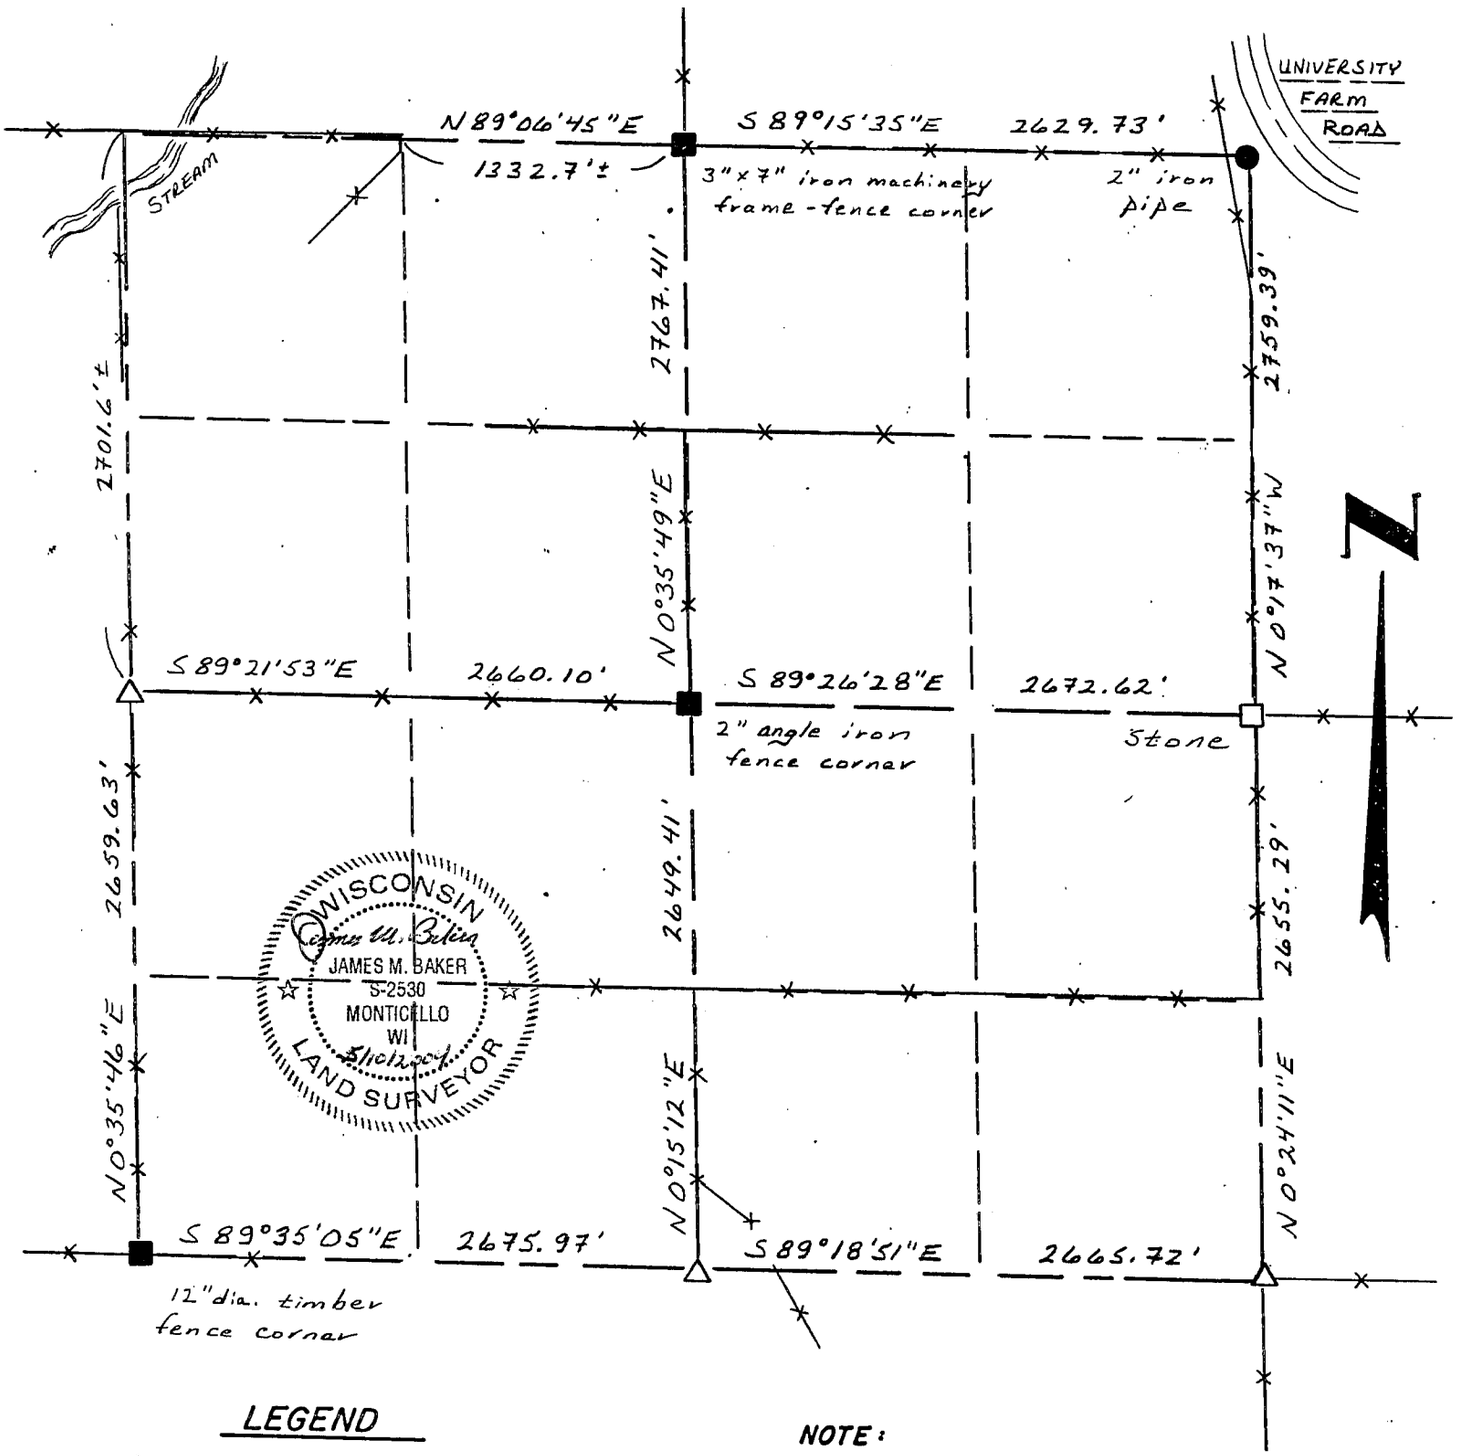

WISCONSIN
JAMES M. BAKER
S-2530
MONTICELLO
WI
LAND SURVEYOR

LEGEND

- △ COUNTY MONUMENT
- □ STONE OR CONCRETE MONUMENT
- ● OTHER (specify) 2" IRON PIPE - FOUND
- ■ EXISTING FENCE CORNER

NOTE:

Relationships of all section corners to other section corners shall be shown hereon by bearing and distance or grid coordinates

Show or describe bearing reference

Bearings are referenced to Grid North of the Grant County Coordinate System as defined by the Wisconsin Department of Transportation and determined by GPS observation.

FORM LC 103