U.S. PUBLIC LAND SURVEY MONUMENT RECORD

Section 15, Town 4 North Range 6 West, Town of Glen Haven, Grant County, Wisconsin

CERTIFICATE

I, Larry L. Austin, do hereby certify that the corner location on this record was determined by me and/or under my direct supervision and that this U.S. public land survey monument record is correct and complete to the best of my knowledge and belief.

Larry L. Austin 5.5.08

Larry L. Austin, S-1903 date

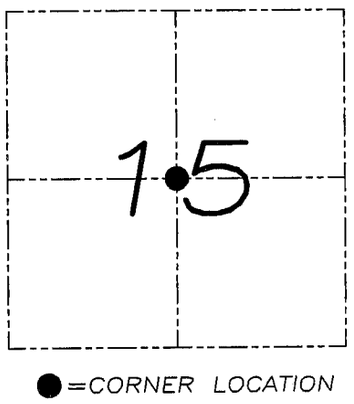

HISTORY OF CORNER

Corner was originally set in 1859 by Hayden. No recent record of the corner was found.

CORNER EVIDENCE FOUND

When I computed the location based on Hayden, I found two monuments of unknown origin. I set the monument based on recorded Hayden measurements. I showed the relationship to the other monuments. Verified this location using EDM & GPS methods.

DESCRIPTION OF CORNER AND WITNESS MONUMENTS, references and accessories used to perpetuate the original or re-established location of this corner. Witnesses to monument location Bobby Sedgwick & Brad Digman & Shane Austin

SKETCH:

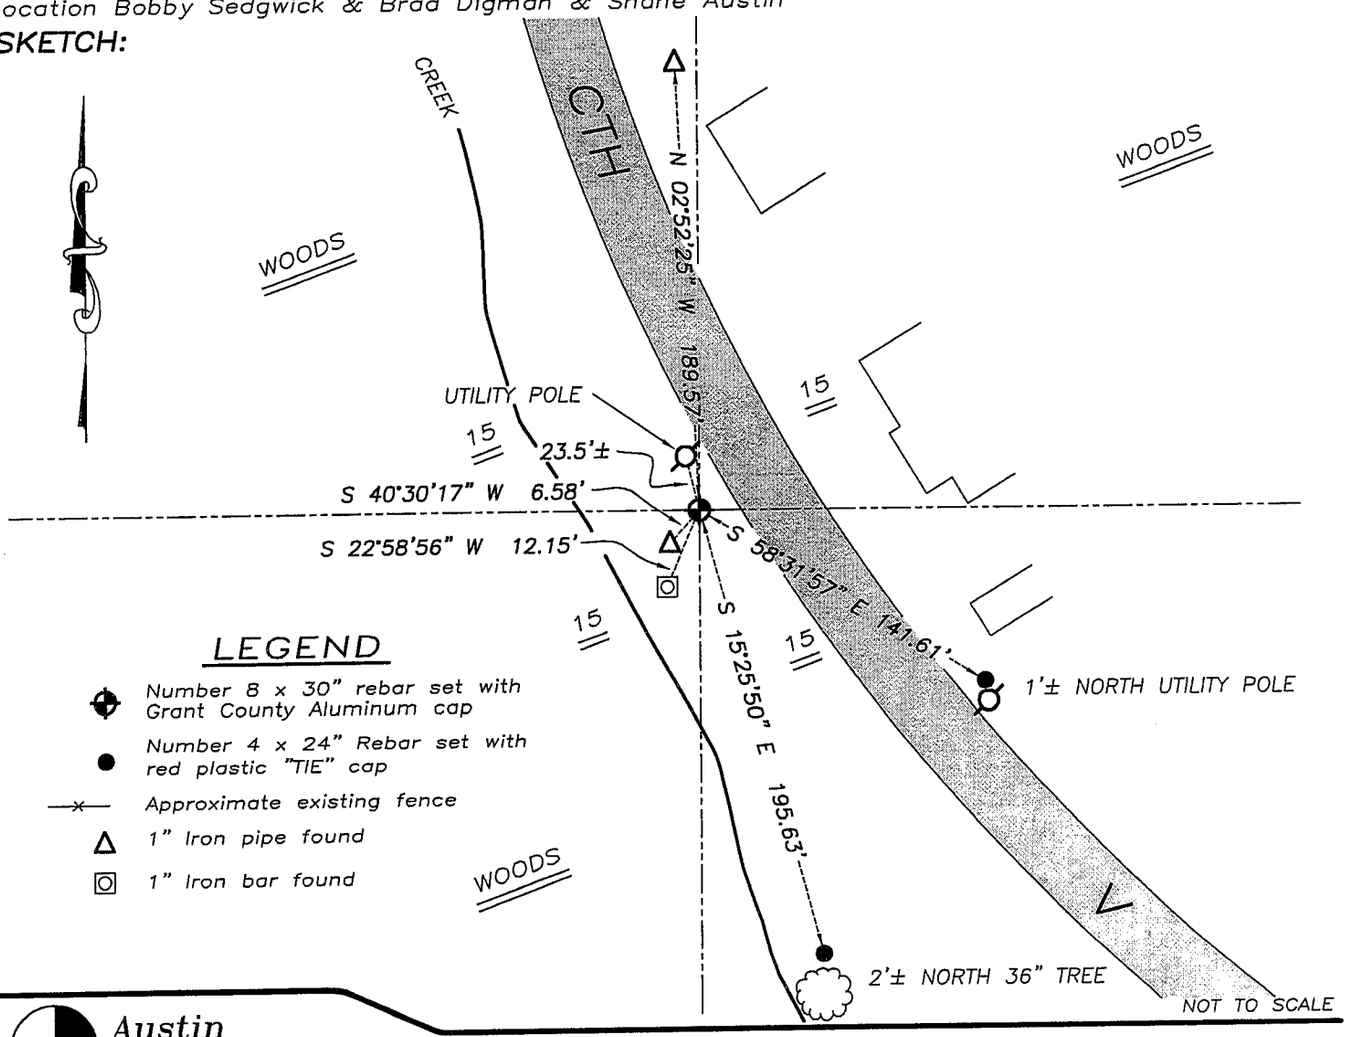

Austin Engineering LLC
4211 HWY 81 E, LANCASTER, WI 53813
PHONE 608-723-6363 FAX 608-723-6702

JOB NUMBER 07S352
FIELDBOOK: TDSR, 2800
G:\T4NR6W\10
H:\TIE\T4NR6W\57.5

DRAWN BY: SW AUSTIN
APPROVED: LL AUSTIN

57.5