U.S. PUBLIC LAND SURVEY MONUMENT RECORD

Section 25, Town 4 North Range 6 West, Town of Glen Haven, Grant County, Wisconsin

CERTIFICATE

I, Larry L. Austin, do hereby certify that the corner location on this record was determined by me and/or under my direct supervision and that this U.S. public land survey monument record is correct and complete to the best of my knowledge and belief.

WISCONSIN LARRY L. AUSTIN S-1903 LANCASTER WI LAND SURVEYOR

Larry L. Austin, S-1903 date 12.1.07

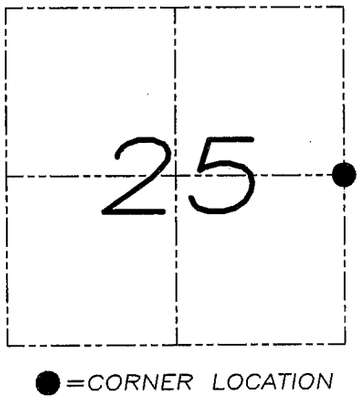

HISTORY OF CORNER

Corner was originally set by Lyon.
No other recent record of the corner was found.

CORNER EVIDENCE FOUND

I set the corner at the proportioned offset from the existing West 1/4 of Section 30, T4N R5W. Verified this location using EDM & GPS methods.

DESCRIPTION OF CORNER AND WITNESS MONUMENTS, references and accessories used to perpetuate the original or re-established location of this corner. Witnesses to monument location Bobby Sedgwick & Brad Digman & Shelby Blindert

SKETCH:

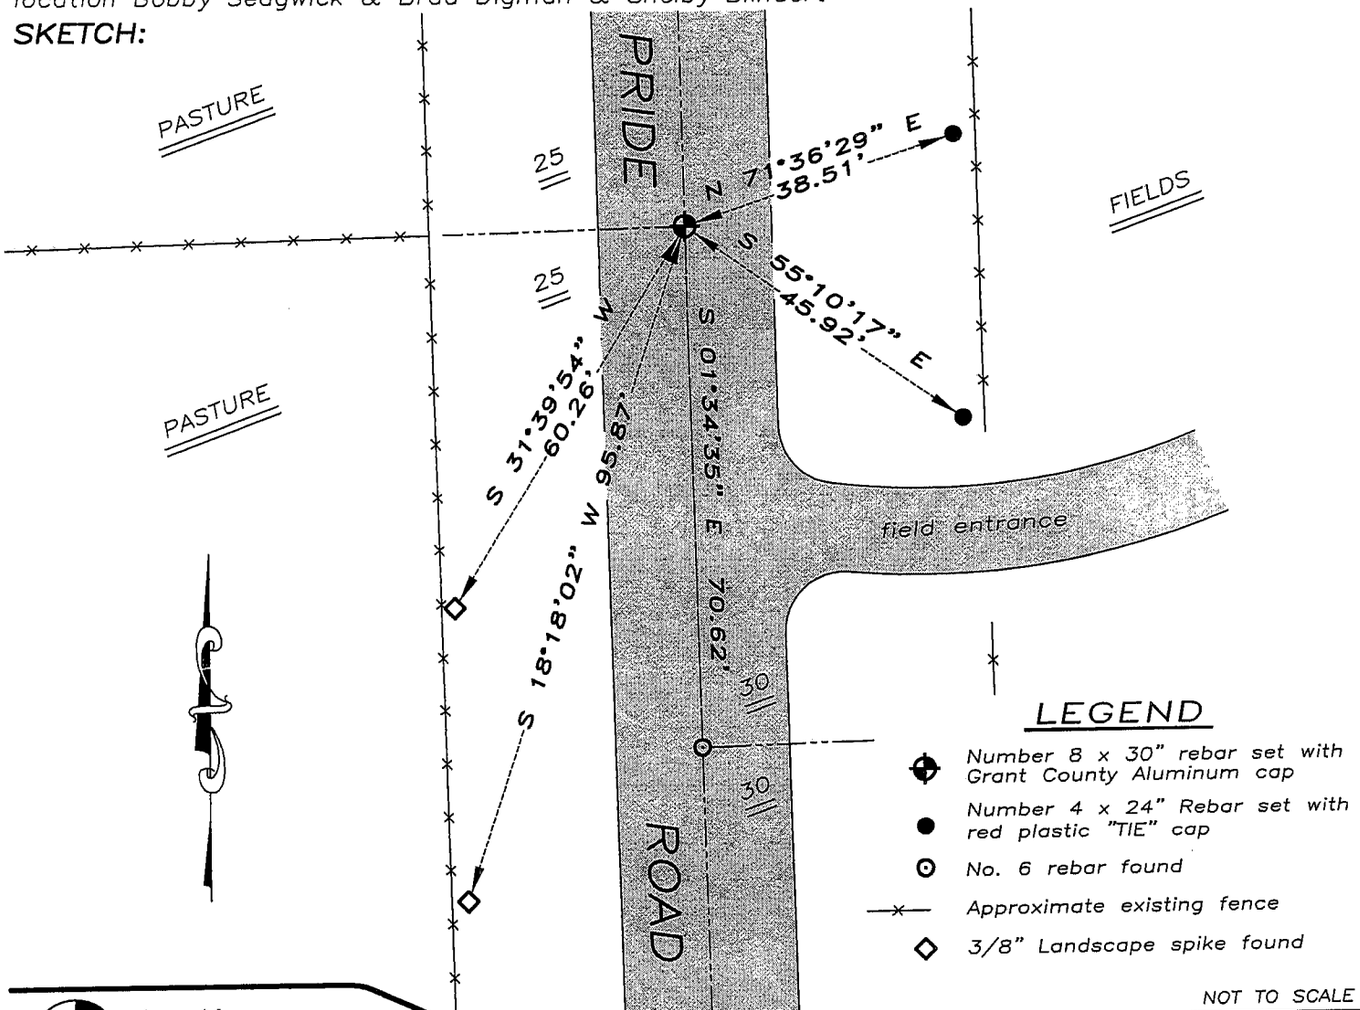

NOT TO SCALE

Austin Engineering LLC
4211 HWY 81 E, LANCASTER, WI 53813
PHONE 608-723-6363 FAX 608-723-6702

JOB NUMBER 07S266
FIELDBOOK: TDSR, 2710
G:\T4NR5W\30
H:\TIE\T4NR6W\100

DRAWN BY: SW AUSTIN
APPROVED: LL AUSTIN

100