53029

U.S PUBLIC LAND SURVEY MONUMENT RECORD - GRANT COUNTY, WI

SECTION 5, TOWN 5 NORTH, RANGE 3 WEST, TOWN OF NORTH LANCASTER (a)

NOTE: THIS FORM IS INTENDED AND DESIGNED TO FULFILL ALL REQUIREMENTS OF THE WISCONSIN ADMINISTRATIVE CODE CHAPTER A-E 7.08, U.S. PUBLIC LAND SURVEY MONUMENT RECORD (3) (a) (b) (c) (d) (e) (f) (g) (h) (i).

CERTIFICATE (i)

I, STANLEY J. KING, DO HEARBY CERTIFY THAT THE CORNER LOCATION ON THIS RECORD WAS DETERMINED BY ME AND/ OR UNDER MY DIRECT SUPERVISION AND THAT THIS U.S PUBLIC LAND SURVEY MONUMENT RECORD IS CORRECT AND COMPLETE TO THE BEST OF MY KNOWLEDGE AND BELIEF.

DATED THIS 12th DAY OF July, 2021

STANLEY J. KING, S-2001

GRANT COUNTY CORNER ID: 53029

WISCONSIN
STANLEY J. KING
S-2001
KIELER
WI
LAND SURVEYOR

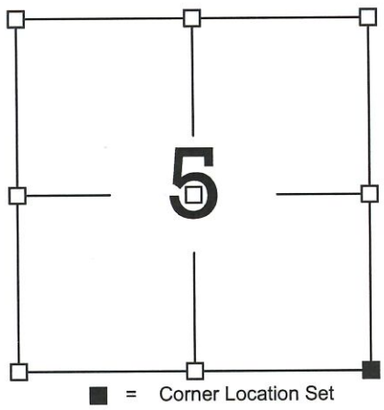

HISTORY OF CORNER ESTABLISHMENT:

CORNER WAS ORIGINALLY SET IN THE YEAR 1832 BY HARVEY PARK. NO REFERENCE TO MONUMENT HAS BEEN FOUND SINCE THAT TIME.

DESCRIPTION OF CORNER EVIDENCE FOUND: (b) (f) (g) (h)

NO RECORD OF MONUMENT WAS FOUND FOR SECTION CORNER. NO MONUMENT WAS FOUND IN ITS PLACE. CORNER SET AT 2,661.95' FROM S¼ CORNER OF SECTION 5. THIS IS BASED UPON THE ORIGINAL NOTES BETWEEN THE S¼ OF 5 AND S¼ OF 4, WHICH HAD AN ORIGINAL DISTANCE OF 79.89 CHAINS (40.04 CH FROM S¼ OF SEC 5). WE PRORATED BASED UPON MEASURED LINE. IT FELL WITHIN 0.75' OF FOUND I BEAM IN CONCRETE. NORTH SOUTH LOCATION WAS SET 33.00' SOUTH OF FOUND I BEAM IN CONCRETE.

DESCRIPTION OF CORNER AND WITNESS MONUMENTS, REFERENCES AND ACCESSORIES USED TO PERPETUATE THE ORIGINAL OR RE-ESTABLISHED LOCATION OF THIS CORNER. (c) (d) (e) WITNESSES TO THE CORNER LOCATION J. SEWELL, AND G. BONN.

SKETCH:

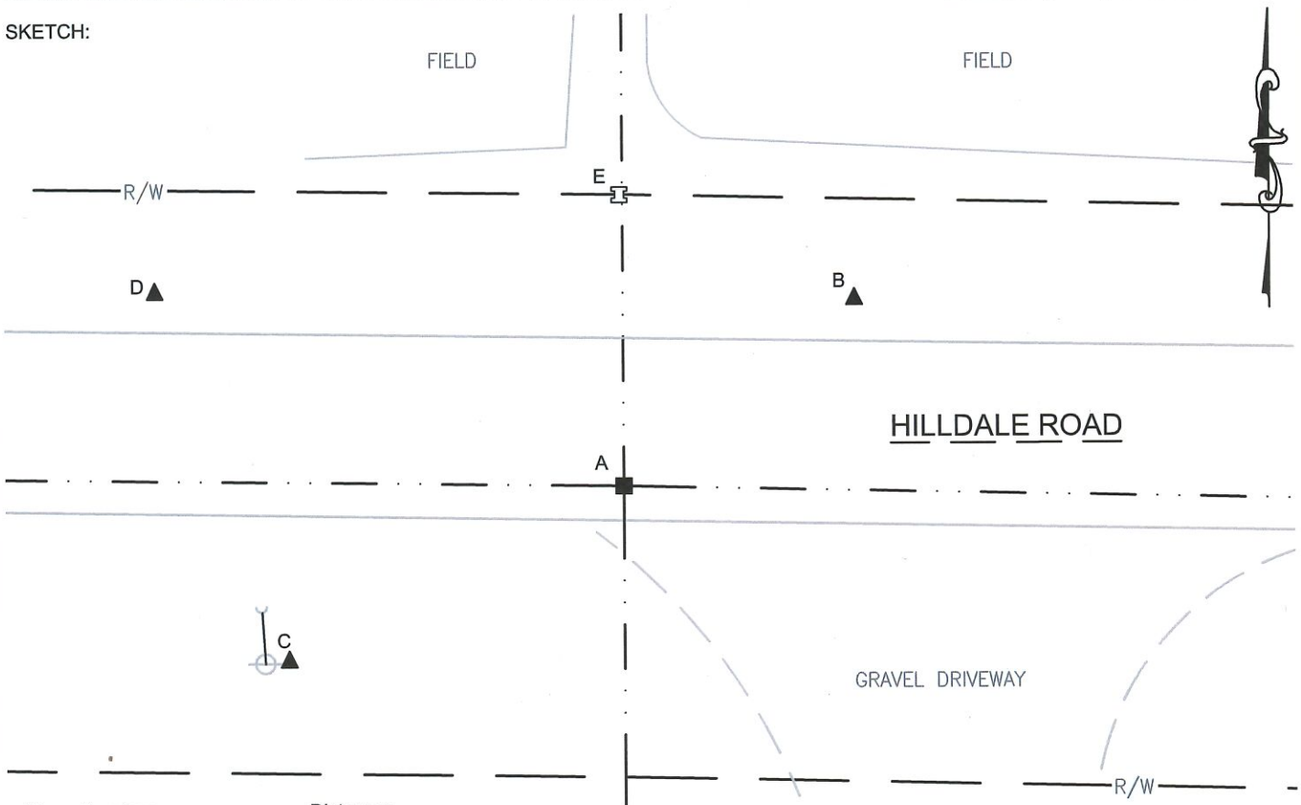

Line:	Bearing:	Distance:
A-B	N 51°14'53" E	33.73'
A-C	S 62°36'47" W	43.00'
A-D	N 67°29'07" W	57.60'
A-E	N 00°38'01" W	33.00'

GRANT COUNTY COORDINATES:
NAD 83 (2011)
NORTHING: 553759.01
EASTING: 809790.90

SCALE: 1" = 20'

0' 20' 40'

LEGEND

- SECTION LINE
- RIGHT-OF-WAY
- ▲ SET 1/2" X 18" REBAR - WT = 0.67 #/L.F.
- ■ SET 1-1/4" X 18" REBAR - WT=4.30 #/L.F.
- FOUND I-BEAM SET IN CONCRETE
- POWER POLE

DATA: Q:\Projects\2020\D20-054 Cooley Farm Survey\Survey\CAD\TIE SHEET\D20-054_TIE_SHEET.dwg
FIELD BOOK: 2020 #3
DATE OF FIELDWORK: 2020-03-24
DRAWN BY: J. SEWELL
REVIEWED BY: D. DREESSENS

DELTA 3
EVERY ANGLE COVERED