MAR 24 2000

GRANT COUNTY
CERTIFIED LAND CORNER

CERTIFICATE:

I, Larry L. Austin, do hereby certify that on the 9th day of September, 1999, I found evidence of the East 1/4 corner of Section 13, Town 5 North, Range 3 West, of the Fourth Principal Meridian, and I re-established said corner according to the Wisconsin Statutes as shown and described heron.

DATED THIS 31st DAY OF JANUARY, 2000

Larry L. Austin S-1903

WISCONSIN LARRY L. AUSTIN S-1903 LANCASTER WI LAND SURVEYOR

SEAL

CORNER NUMBER 60

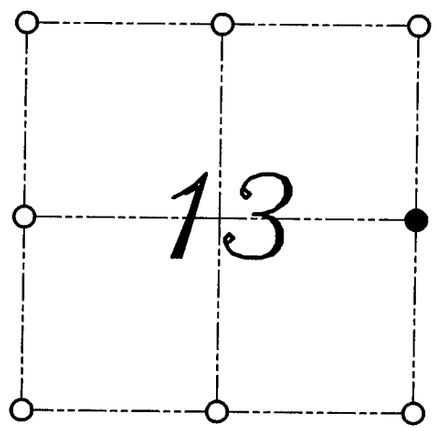

● = CORNER LOCATION

EAST 1/4 CORNER OF SECTION 13, T 5 N R 3 W TOWN OF NORTH LANCASTER

HISTORY OF ORIGINAL CORNER ESTABLISHMENT:

Corner was originally set in 1832 by Sibley. Joel Barber tied to the corner in 1875 and found the corner to be 27 Links South of the West 1/4 of Section 18.

DESCRIPTION OF CORNER EVIDENCE FOUND:

I found an occupied fence corner at the West 1/4 of Section Eighteen. I set the East 1/4 of Section Thirteen 27 Links South of the fence corner. Verified this location using E.D.M. and G.P.S. methods.

DESCRIPTION OF CORNER AND WITNESS MONUMENTS, *references and accessories used to perpetuate the original or re-established location of this corner*

WITNESS TO THE CORNER LOCATION: SHELBY BLINDERT ; BOBBY SEDGWICK

SKETCH:

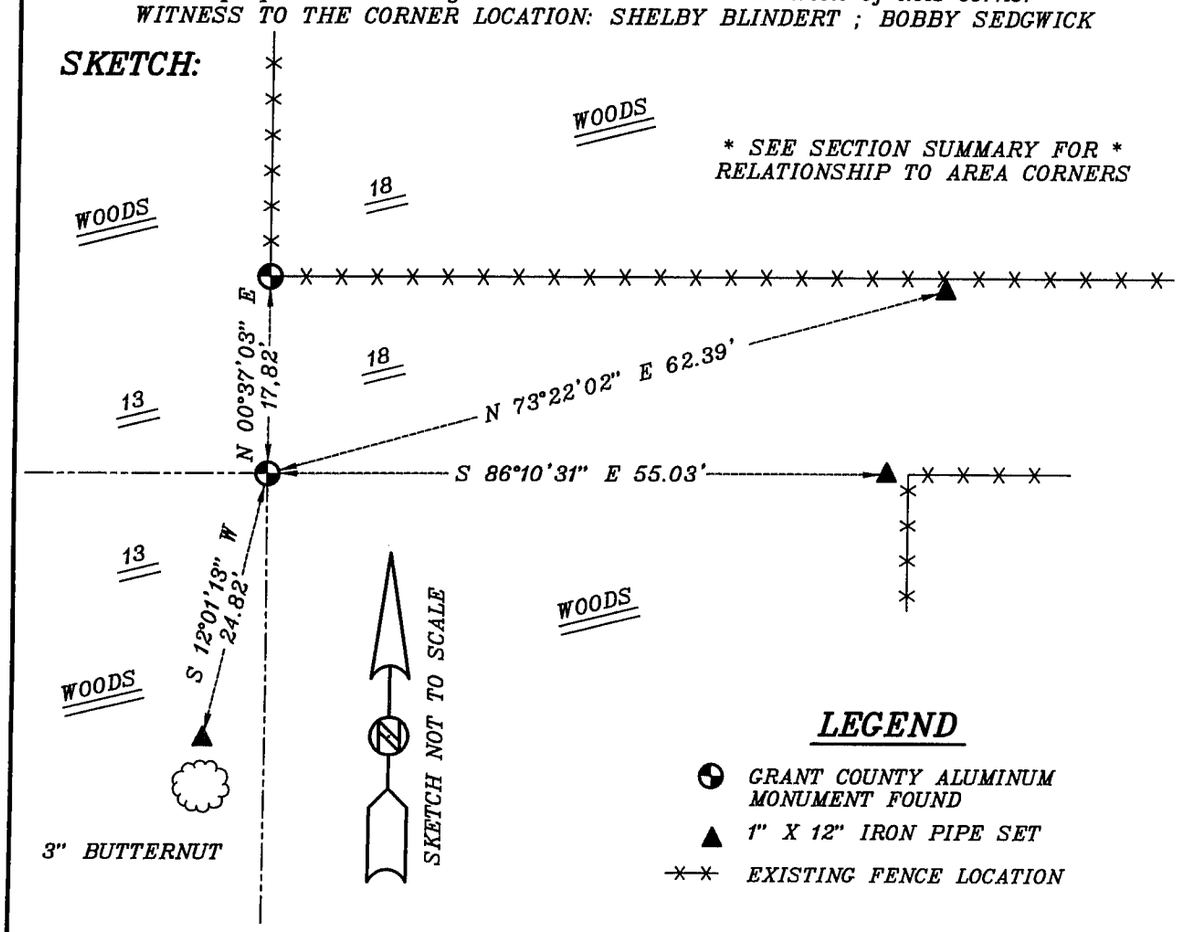

C:\SC14\SWA\TIE\T5NR3W\60

60