

Survey Monument Record

TYPE OF MONUMENT 3/4" X 24" IRON
BAR SET


CORNER NO. 77
SECTION 22
TOWN 5N
RANGE 3W

FIELD BOOK: 96-17
PAGE (5)

BASIS FOR MONUMENT LOCATION

(Use reverse side if necessary)

Show info such as: History of corner, with reference to Vol. and pg., dates, surveyor; exact description of monument replaced; if location computed, by taped or EDM traverse; landowner, remarks, etc.

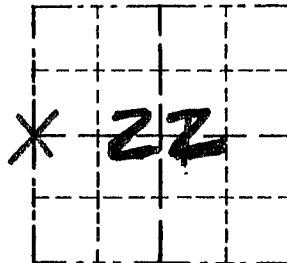


LOCATION
(Indicated by "X")



SEAL:

CORNER SET BY HARVEY,
CLARK. NO RECORD OF
CORNER FOUND SINCE ORIGINAL
SURVEY; CORNER WAS SET
AT A OCCUPIED FENCE
CORNER. VERIFIED ITS
LOCATION USING EDM
METHODS.

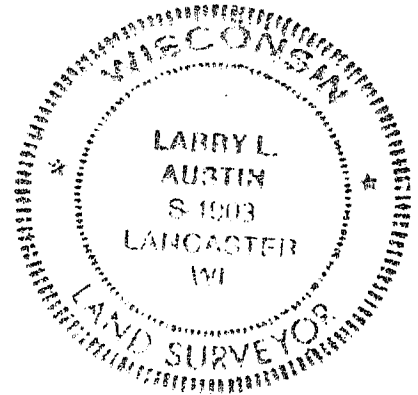

CERTIFIED CORRECT

Larry L. Austin
Registered Land Surveyor

DATE: 7-30-97

TIE SKETCH

Show at least three (3) ties and monument

LEGEND

PASTURE

● 3/4 X 24" IRON BAR SET

○ 1/2" X 18" IRON BAR SET

XX EXISTING FENCE

