FOR GRANT COUNTY, WISCONSIN

Note: This form is intended and designed to fulfill all requirements of Wisconsin Administrative Code, Chapter AE-7.08, U.S. Public Land Survey Monument Record (3)(a)(b)(c)(d)(e)(f)(g)(h)(i). Use additional sheets if necessary.

(a) The ~~Section~~, X One Quarter corner common to Section 31

Township(s) _____5_____ North, Range(s)_____03_____West

State Plane Coordinates: N_____

Datum: _____ E _____

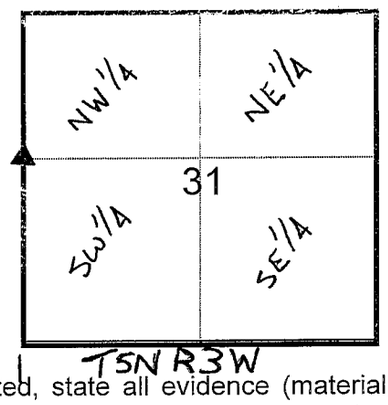

(b)(f)(h) Description of monument found at this corner and if it was accepted, state all evidence (material, testimonial, occupational, plats records, other monuments) used as a basis for accepting. If not accepted or nothing was found, state evidence used as basis for establishing location and what was set. If re-established through lost corner proportionate methods, indicate all monuments, distances and directions used.

Used aerial photography to narrow search area down to a minimum. Found the E1/4 corner of Section 36 to the West. Tie sheet for corner ½ mile North shows 24 link separation between section corners of these two sections. Separation here should be 12 links. Set W1/4 corner of Section 31(T05N, R03W) twelve links (7.92 feet) South of E1/4 corner of Section 36, (T05N, R04W). Corner is approximately three hundred feet North of the centerline of County Trunk Highway "A".

(c)(d)(e) Plan view of corner with ties to at lest four (4) witness monuments. If in disagreement with previously established corner, show the distances between the two corners and also indicate ties to disputed corner.

- Section corner monument set - #10 rebar
- Witness monuments set - #5 rebar
- Section corner found – Aluminum cap.

NORTH

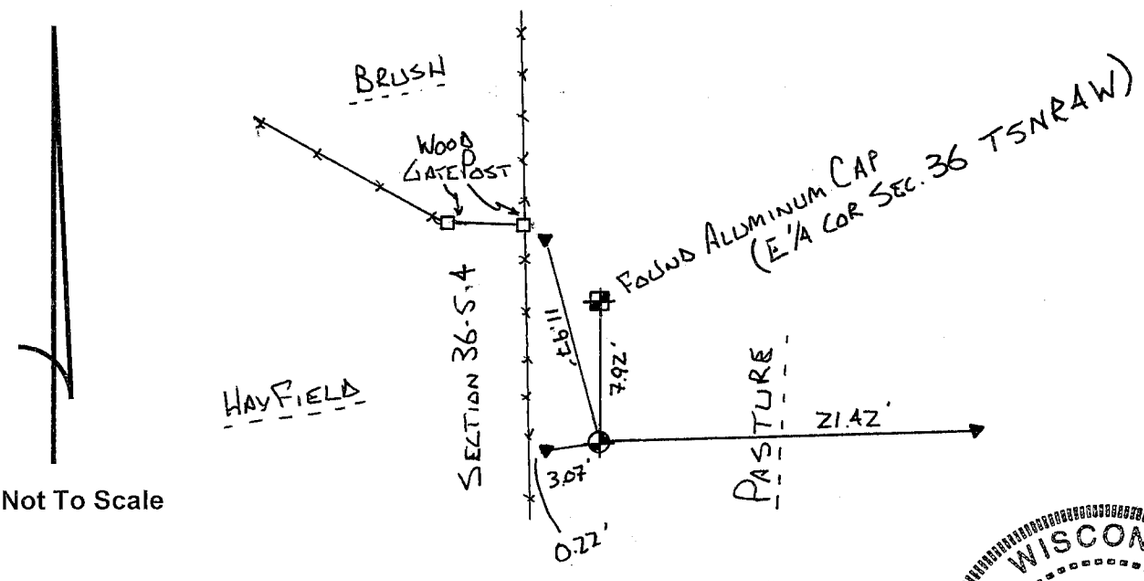

Not To Scale

(I) Certify that the corner location on this record was determined by me or under my direction and control and that this U.S. Public Land survey Monument Record is correct and complete to the best of my knowledge and belief.

WISCONSIN
HARVEY G. JOHNSON
S-1899
WAUNAKEE
WIS
LAND SURVEYOR

Harvey Johnson Sept. 7, 2004
Signature Date

Filed for record in Grant County Surveyor's Office on _____ **INDEX NO.** 114