U.S. PUBLIC LAND SURVEY MONUMENT RECORD

Section 7, Town 5 North Range 4 West, Town of Little Grant, Grant County, Wisconsin

CERTIFICATE

I, Larry L. Austin, do hereby certify that the corner location on this record was determined by me and/or under my direct supervision and that this U.S. public land survey monument record is correct and complete to the best of my knowledge and belief.

Larry L Austin 8-15-09

Larry L. Austin, S-1903 date

WISCONSIN LARRY L. AUSTIN S-1903 LANCASTER WI LAND SURVEYOR

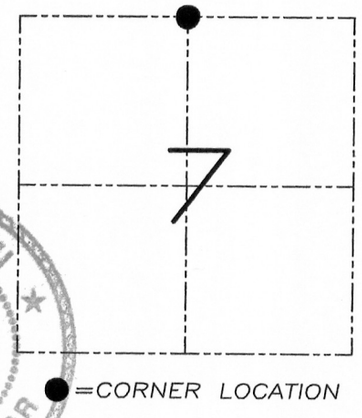

HISTORY OF CORNER

Corner was originally set in 1833 by Harvey Parke. No other record of the corner was found.

CORNER EVIDENCE FOUND

I found an existing fence line to the North and utilized the centerline of a township road running East–West. I accepted this location as the best evidence for the corner location and verified this location with G.P.S. and E.D.M. methods.

DESCRIPTION OF CORNER AND WITNESS MONUMENTS, references and accessories used to perpetuate the original or re-established location of this corner. Witnesses to monument location Bobby Sedgwick & Brad Digman.

SKETCH:

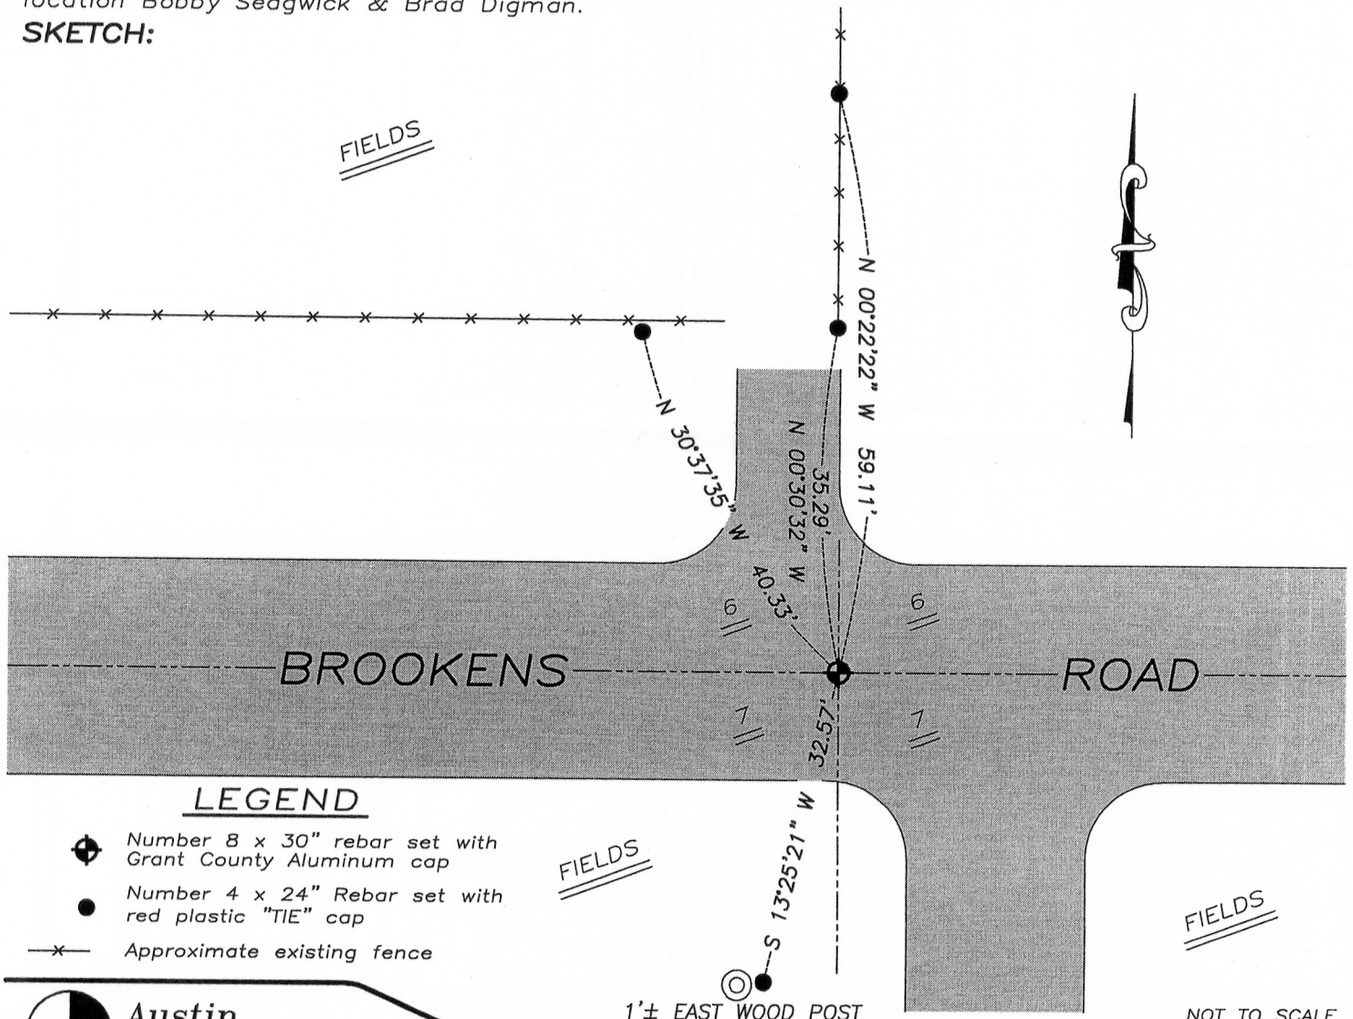

NOT TO SCALE

Austin Engineering LLC
4211 HWY 81 E, LANCASTER, WI 53813
PHONE 608-723-6363 FAX 608-723-6702

JOB NUMBER 09S140-CRUBEL
FIELDBOOK: TDSR, 2811
G:\T5NR4W\28
H:\TIE\T5NR4W\32

DRAWN BY: SW AUSTIN
APPROVED: LL AUSTIN

32

NOV 04 2011