U.S. PUBLIC LAND SURVEY MONUMENT RECORD

Section 7, Town 5 North Range 4 West, Town of Little Grant, Grant County, Wisconsin

CERTIFICATE

I, Larry L. Austin, do hereby certify that the corner location on this record was determined by me and/or under my direct supervision and that this U.S. public land survey monument record is correct and complete to the best of my knowledge and belief.

Larry L. Austin, S-1903 — date 8.15.09

WISCONSIN LARRY L. AUSTIN S-1903 LANCASTER WI LAND SURVEYOR

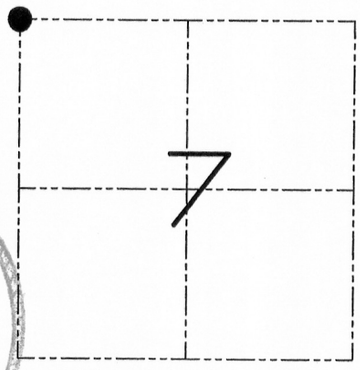

● =CORNER LOCATION

HISTORY OF CORNER

Corner was originally set in 1833 by Harvey Parke.
No other record of the corner was found.

CORNER EVIDENCE FOUND

I reset the corner at the proportional offset from the existing Northeast corner of Section 12, T5N R5W. I verified its location by E.D.M. and G.P.S. methods.

DESCRIPTION OF CORNER AND WITNESS MONUMENTS, references and accessories used to perpetuate the original or re-established location of this corner. Witnesses to monument location Bobby Sedgwick & Brad Digman & Shelby Blindert.

SKETCH:

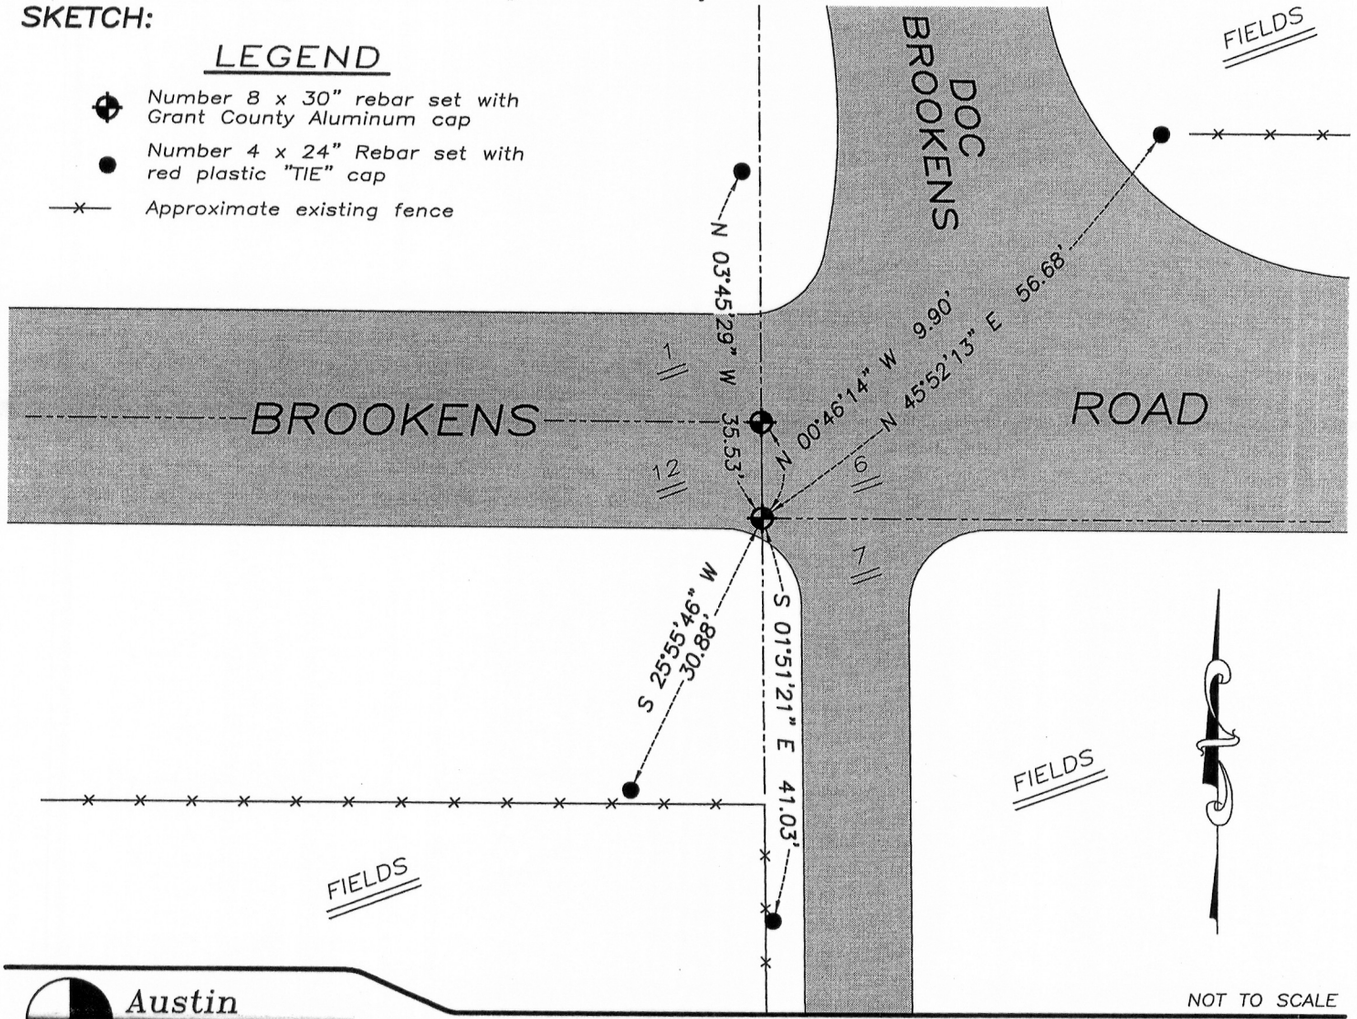

Austin Engineering LLC
4211 HWY 81 E, LANCASTER, WI 53813
PHONE 608-723-6363 FAX 608-723-6702

JOB NUMBER 09S140-CRUBEL
FIELDBOOK: T5SR, 28T1
G:\T5NR4W\28
H:\TIE\T5NR4W\33

DRAWN BY: SW AUSTIN
APPROVED: LL AUSTIN

NOV 0 4 2011