# U.S. PUBLIC LAND SURVEY MONUMENT RECORD - GRANT COUNTY, WI

## Section 34, Town 5 North Range 6 West, Town of Bloomington

***CERTIFICATE***

I, Larry L. Austin, do hereby certify that the corner location on this record was determined by me and/or under my direct supervision and that this U.S. public land survey monument record is correct and complete to the best of my knowledge and belief.

Dated this 25th day of October, 2007

Larry L. Austin S-1903

WISCONSIN LARRY L. AUSTIN S-1903 LANCASTER WI LAND SURVEYOR

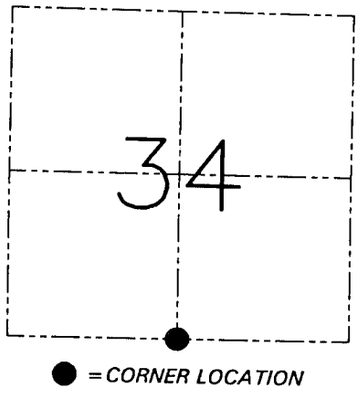


***HISTORY OF CORNER ESTABLISHMENT***

Corner was originally set in 1832 by Sibley.
In 1962 Kenneth Cullen set a concrete monument.

***DESCRIPTION OF CORNER EVIDENCE FOUND***

I found Cullen's concrete monument and did not accept it's location. I reset the corner at the recorded distance from the Southeast corner of Section 34. Verified this location using EDM & GPS methods.

***DESCRIPTION OF CORNER AND WITNESS MONUMENTS,*** *references and accessories used to perpetuate the original or re-established location of this corner. Witnesses to the corner location Bobby Sedgwick & Shane Austin & Tim Fauver*

SKETCH:

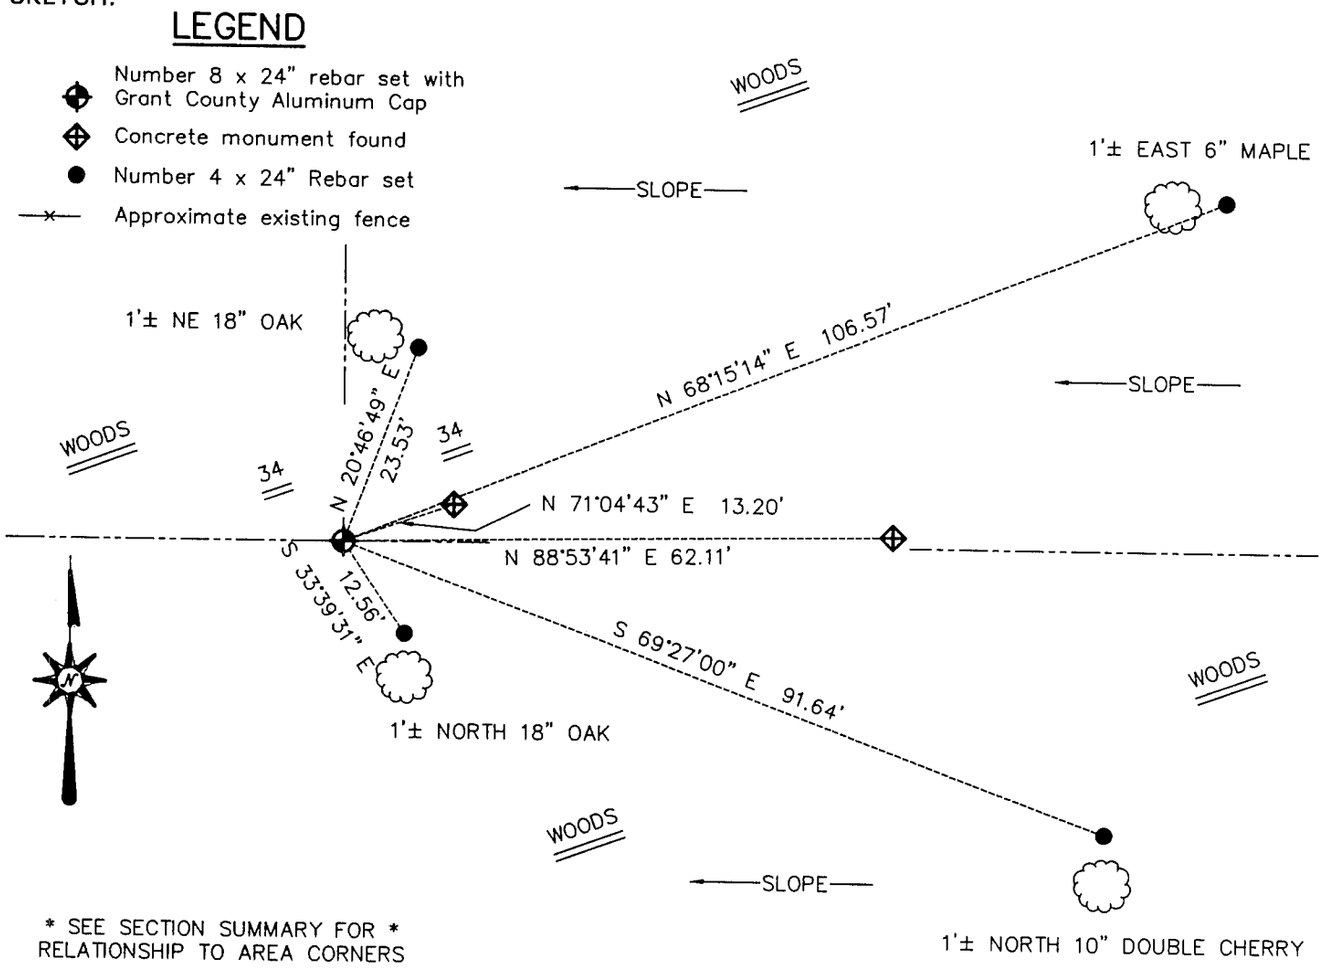


* SEE SECTION SUMMARY FOR * RELATIONSHIP TO AREA CORNERS

SKETCH NOT TO SCALE


**AUSTIN ENGINEERING, LLC**

4211 HWY 81 EAST, LANCASTER, WI 53813
PHONE 608-723-6363 FAX 608-723-6702


FIELDBOOK: SDR33, 2106, 2107, 2041
G:\T5NR6W\34
C:\SWA\TIE\T5NR6W\126
CREW: BS-SB-SA-TF

DRAWN BY: SW AUSTIN
APPROVED: LL AUSTIN

**CORNER NUMBER 126**