U.S. PUBLIC LAND SURVEY MONUMENT RECORD

Section 21, Town 6 North Range 6 West, Town of Wyalusing, Grant County, Wisconsin

CERTIFICATE

I, Larry L. Austin, do hereby certify that the corner location on this record was determined by me and/or under my direct supervision and that this U.S. public land survey monument record is correct and complete to the best of my knowledge and belief.

Larry L. Austin, S-1903

WISCONSIN LARRY L. AUSTIN S-1903 LANCASTER WI LAND SURVEYOR

date 11-25-20

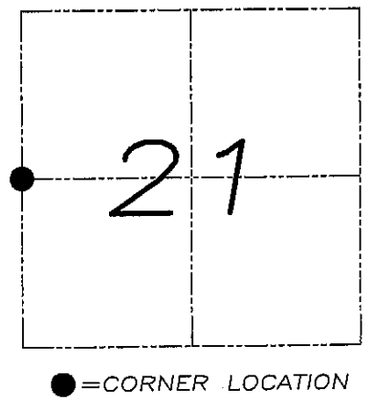

HISTORY OF CORNER

Corner was originally set in 1832 by Clark.
No other record of the corner was found.

CORNER EVIDENCE FOUND

I reset the corner at an occupied location as shown below. Verified this location using EDM & GPS methods.

DESCRIPTION OF CORNER AND WITNESS MONUMENTS, references and accessories used to perpetuate the original or re-established location of this corner. Witnesses to monument location Bobby Sedgwick & Brad Digman & Shane Austin

SKETCH:

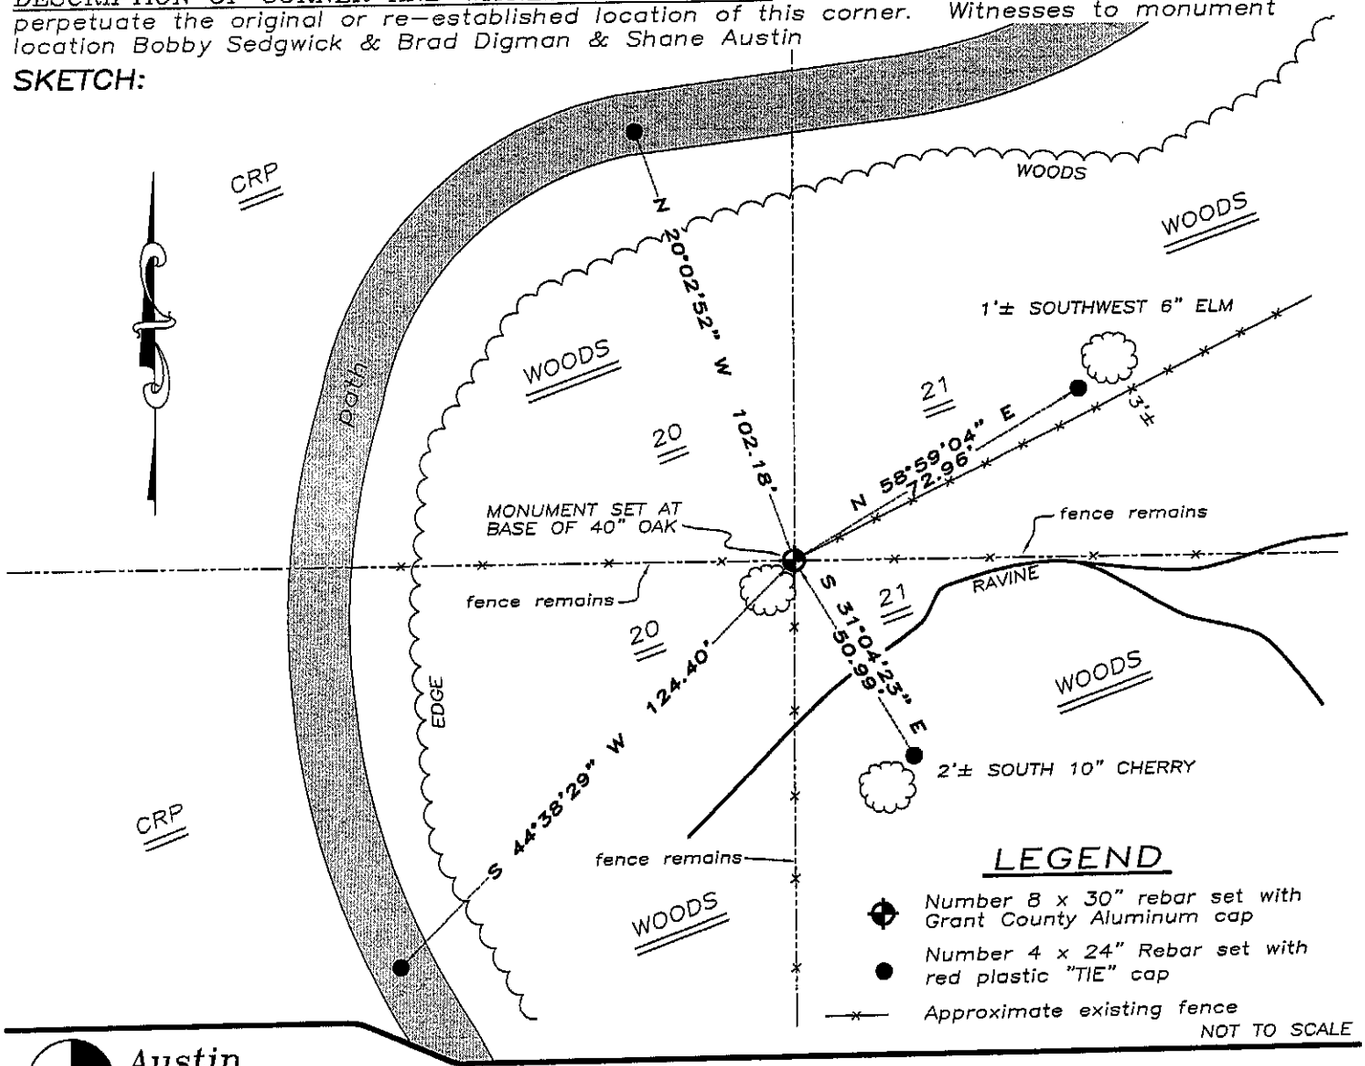

Austin Engineering LLC
4211 HWY 81 E, LANCASTER, WI 53813
PHONE 608-723-6363 FAX 608-723-6702

JOB NUMBER 07S284
FIELDBOOK: TDSR, 2709
G:\T6NR6W\33
H:\TIE\T6NR6W\76

DRAWN BY: SW AUSTIN
APPROVED: LL AUSTIN