# U.S. PUBLIC LAND SURVEY MONUMENT RECORD – GRANT COUNTY, WI

## Section 24, Town 6 North Range 6 West, Town of Wyalusing

**CERTIFICATE**

I, Larry L. Austin, do hereby certify that the corner location on this record was determined by me and/or under my direct supervision and that this U.S. public land survey monument record is correct and complete to the best of my knowledge and belief.

Dated this 28th day of July, 2003

Larry L. Austin S–1903

WISCONSIN
LARRY L. AUSTIN S-1903 LANCASTER WI
LAND SURVEYOR

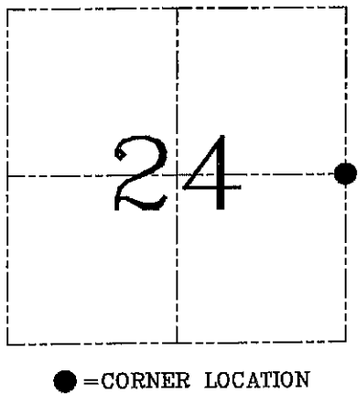


**HISTORY OF CORNER ESTABLISHMENT**

Corner was originally set in 1832 by Sibley.
In 1998 Miller tied to the corner with no mention of monument.

**DESCRIPTION OF CORNER EVIDENCE FOUND**

I was unable to locate any evidence of the Miller location. I reset the corner proportionately between the Northeast and Southeast corners of Section 24. Verified this location using EDM & GPS methods.

**DESCRIPTION OF CORNER AND WITNESS MONUMENTS**, references and accessories used to perpetuate the original or re–established location of this corner. Witnesses to corner location Bobby Sedgwick & Shane Austin & Brad Digman

SKETCH:

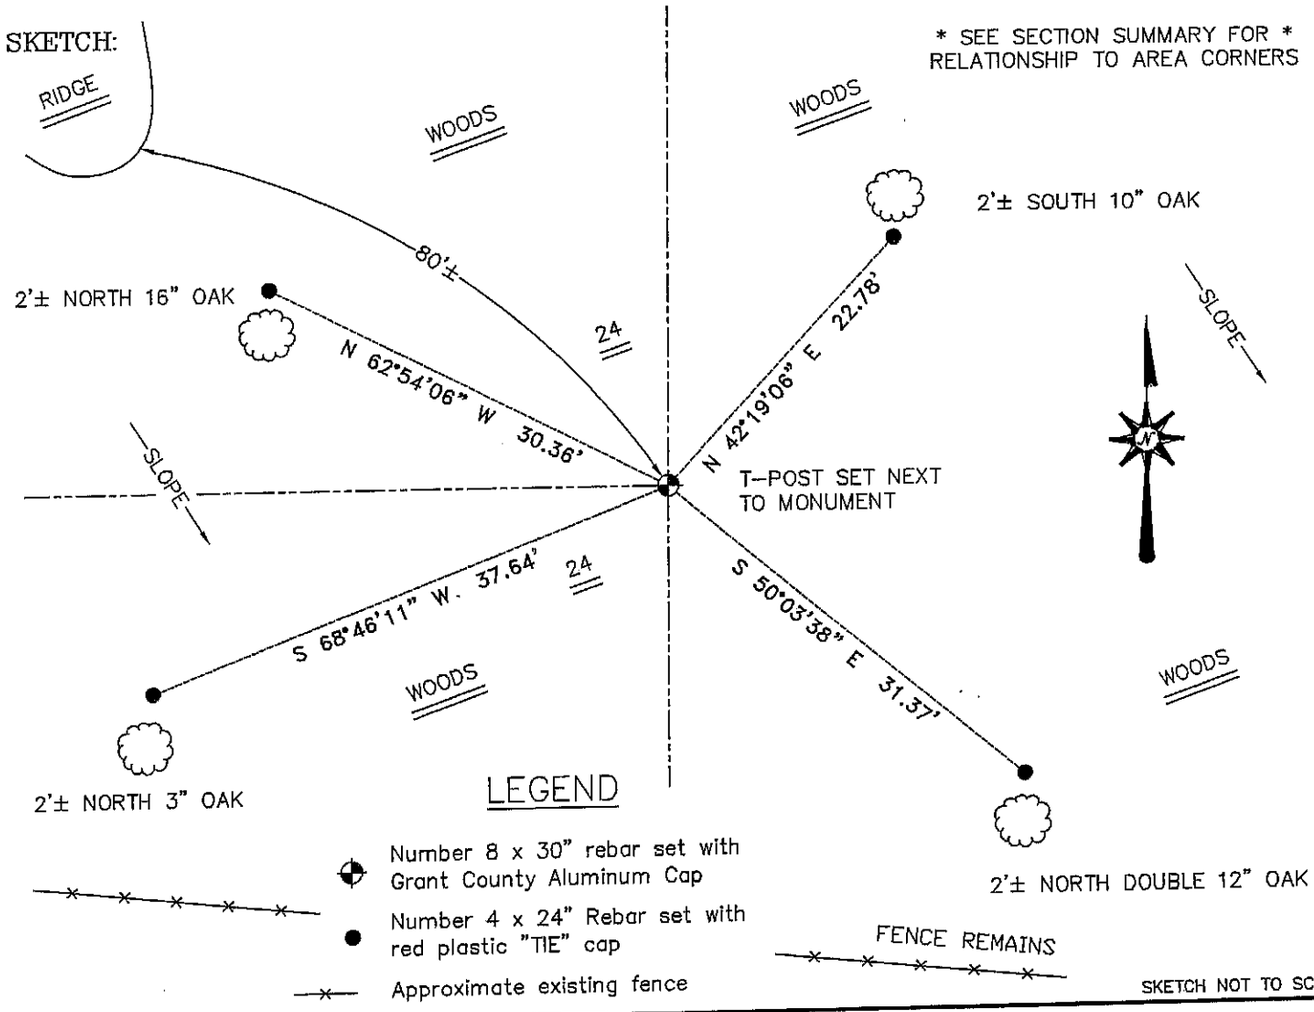


AUSTIN ENGINEERING, LLC
4211 HWY 81 EAST, LANCASTER, WI 53813
PHONE 608–723–6363 FAX 608–723–6702

FIELDBOOK: TDS RNGR, 2307, 2317
G:\T6NR6W\18
H:\TIE\T6NR6W\80
JOB NUMBER 03S122

DRAWN BY: SW AUSTIN
APPROVED: LL AUSTIN

CORNER NUMBER 80