# U.S. PUBLIC LAND SURVEY MONUMENT RECORD - GRANT COUNTY, WI

## Section 32, Town 6 North Range 6 West, Town of Wyalusing

***CERTIFICATE***

I, Larry L. Austin, do hereby certify that the corner location on this record was determined by me and/or under my direct supervision and that this U.S. public land survey monument record is correct and complete to the best of my knowledge and belief.

Dated this 3rd day of May, 2001

Larry L. Austin S-1903

WISCONSIN
LARRY L. AUSTIN S-1903 LANCASTER WI
LAND SURVEYOR

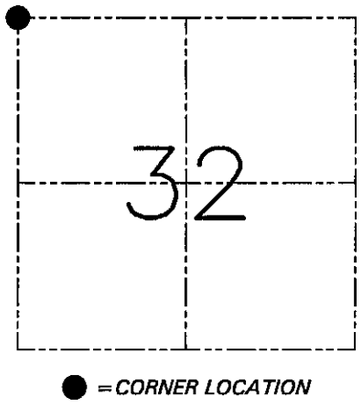


***HISTORY OF CORNER ESTABLISHMENT***

Corner was originally set in 1832 by Robert Clark.
In 1994 Mohn set a 3/4" iron bar at this location.

***DESCRIPTION OF CORNER EVIDENCE FOUND***

I was unable to locate the evidence of Mohn's location. I did find an original bearing tree and set the corner with respect to this. Verified this location using EDM & GPS methods.

***DESCRIPTION OF CORNER AND WITNESS MONUMENTS,*** *references and accessories used to perpetuate the original or re-established location of this corner. Witnesses to the corner location Bobby Sedgwick & Shane Austin & Tim Fauver.*

**SKETCH:**

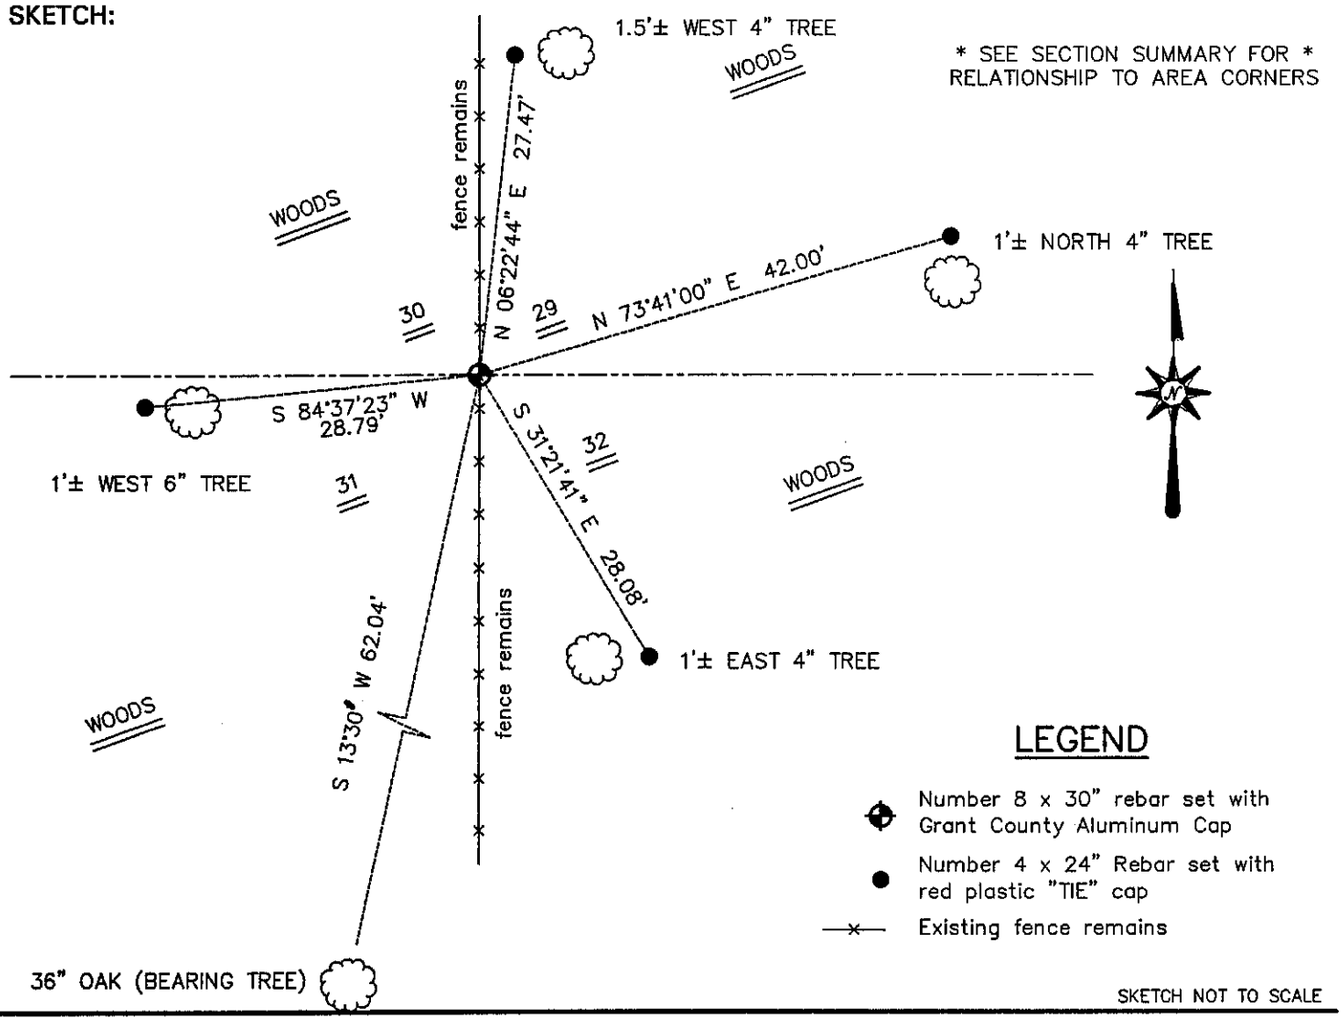



**AUSTIN ENGINEERING, LLC**
4211 HWY 81 EAST, LANCASTER, WI 53813
PHONE 608-723-6363 FAX 608-723-6702


FIELDBOOK: SDR33, 2042
G:\T6NR6W\33
C:\SWA\TIE\T6NR6W\111
CREW: BS-SB-SA-TF

DRAWN BY: SW AUSTIN
APPROVED: LL AUSTIN

**CORNER NUMBER 111**