U.S. PUBLIC LAND SURVEY MONUMENT RECORD

(As Required By s. A-E 7.08, WI Adm. Code)

I accepted an existing 3 way fence intersection as this location. I computed the N 1/4 corner of 5 T7N, R1W at 1/2 the distance between a found monument at the NW corner and the computed easting of the NE corner using relationships shown in a plat of survey by Terry Cornell dated 12/6/1993 and filed in Book W on Page 311. I located the S1/4 of 33, T8N, R1W. See the accompanying Section Summary for these relationships.

Corner was: (Check All That Apply)

- [x] Restored through acceptance of an obliterated evidence location
- [ ] Restored through acceptance of a found perpetuated location
- [x] Considered a lost corner and reestablished through lost corner proportionate methods (include a plan view drawing showing distances and directions to other Public Land Survey Corners used for proportioning and determining the corner location)
- [ ] Restored or reestablished in a location that differs from a previous restoration or reestablishment (include a plan view drawing and indicate what was set and /or found)

Describe the monument and accessories used to perpetuate the location of this corner. (Include a plan view drawing and indicate what was set and/or found)

The S1/4 of 32 T8N R1W / N1/4 of 5 T7N R1W corner of Section ~~____~~ T. ~~____~~ N., R. ~~____~~ E.

Grant County, Wisconsin

Job ID: 2003-10

Book # 6

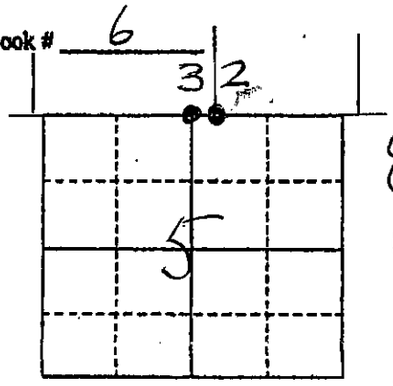

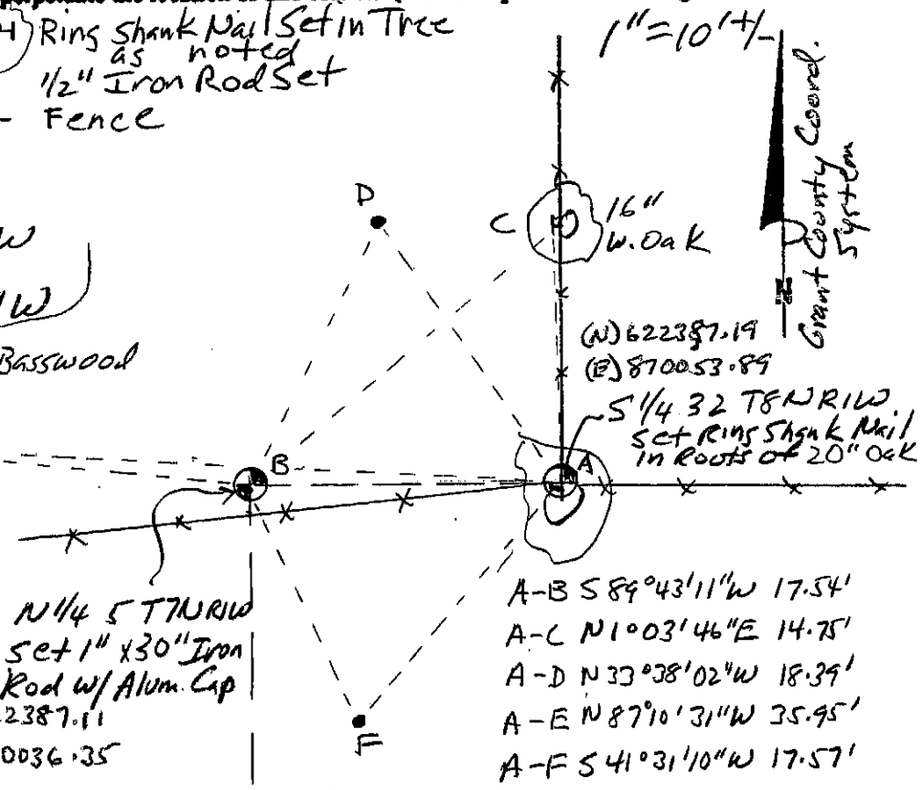

A-B S 89°43'11"W 17.54'
A-C N 1°03'46"E 14.75'
A-D N 33°38'02"W 18.39'
A-E N 87°10'31"W 35.95'
A-F S 41°31'10"W 17.57'

B-C N 50°12'41"E 23.19'
B-D N 25°32'33"E 17.07'
B-E N 84°13'25"W 18.45'
B-F S 24° 17'54"E 14.34'

● = Location of Corner

LAND SURVEYOR'S SEAL
WISCONSIN
MICHAEL R. LaROSA
S-2259
Linden
Wisconsin
LAND SURVEYOR

I, Michael R. LaRosa (Type or print name) certify that the corner location shown on this record was determined by me or under my direction and control and that this U.S. Public Land Survey Monument Record is correct and complete to the best of my knowledge and belief.

Michael R. LaRosa 5/28/2003

Signature Date

Index No. 10