SECTION SUMMARY SHEET

SECTION 11 T 7N R/W

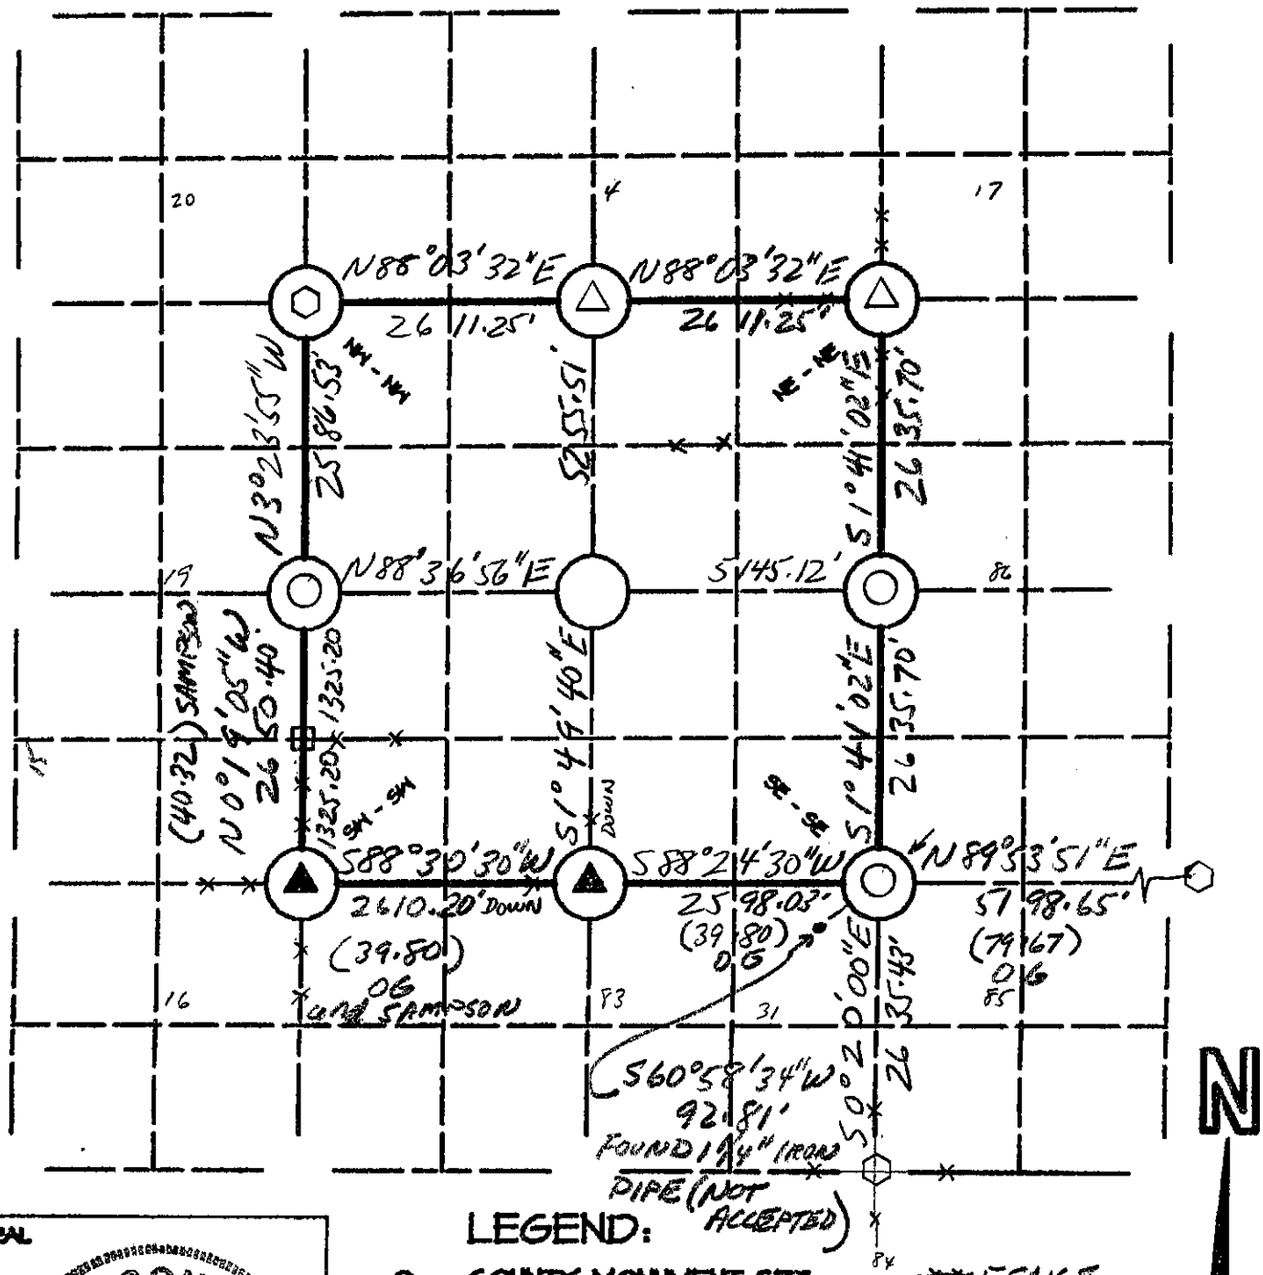

SEAL

WISCONSIN
MICHAEL R.
LaROSA
S-2259
Linden
Wisconsin
LAND SURVEYOR

LEGEND:

- ○ COUNTY MONUMENT SET
- △ COUNTY MONUMENT FOUND
- OTHER(Specify) ▲ FOUND 1-1/4" IRON ROD
- OTHER(Specify) □ FOUND STONE
- OTHER(Specify) ⬡ COMPUTED LOCATION OF CORNER PER TIES TO OLDER RECORD SURVEYS
- *** FENCE
- ( ) RECORDED AS

BEARING REF. GRID NORTH GRANT COUNTY COORD. SYSTEM. SEE TIE SHEETS FOR COORDINATES

MICHAEL R. LAROSA
Michael R. LaRosa
12/1/2005

SIGNATURE DATE

Hortz. Datum ☐ NAD 27 ☐ NAD 83(91) Units ☐ ENGLISH ☐ Metric Co-ordinate System ☐ Geodetic ☐ State Plane(S. zone) ☐ Lat. County	The information provided in this box is not req'd, but requested to be provided if available to the surveyor preparing this sheet, otherwise provide reference in accordance with survey plat related to preparation of this sheet. Place coordinates furnished adjacent to the corner(s) on section sketch above.