GRANT COUNTY
SECTION SUMMARY SHEET

SECTION 18 T 7 N R 2 ~~E~~ W

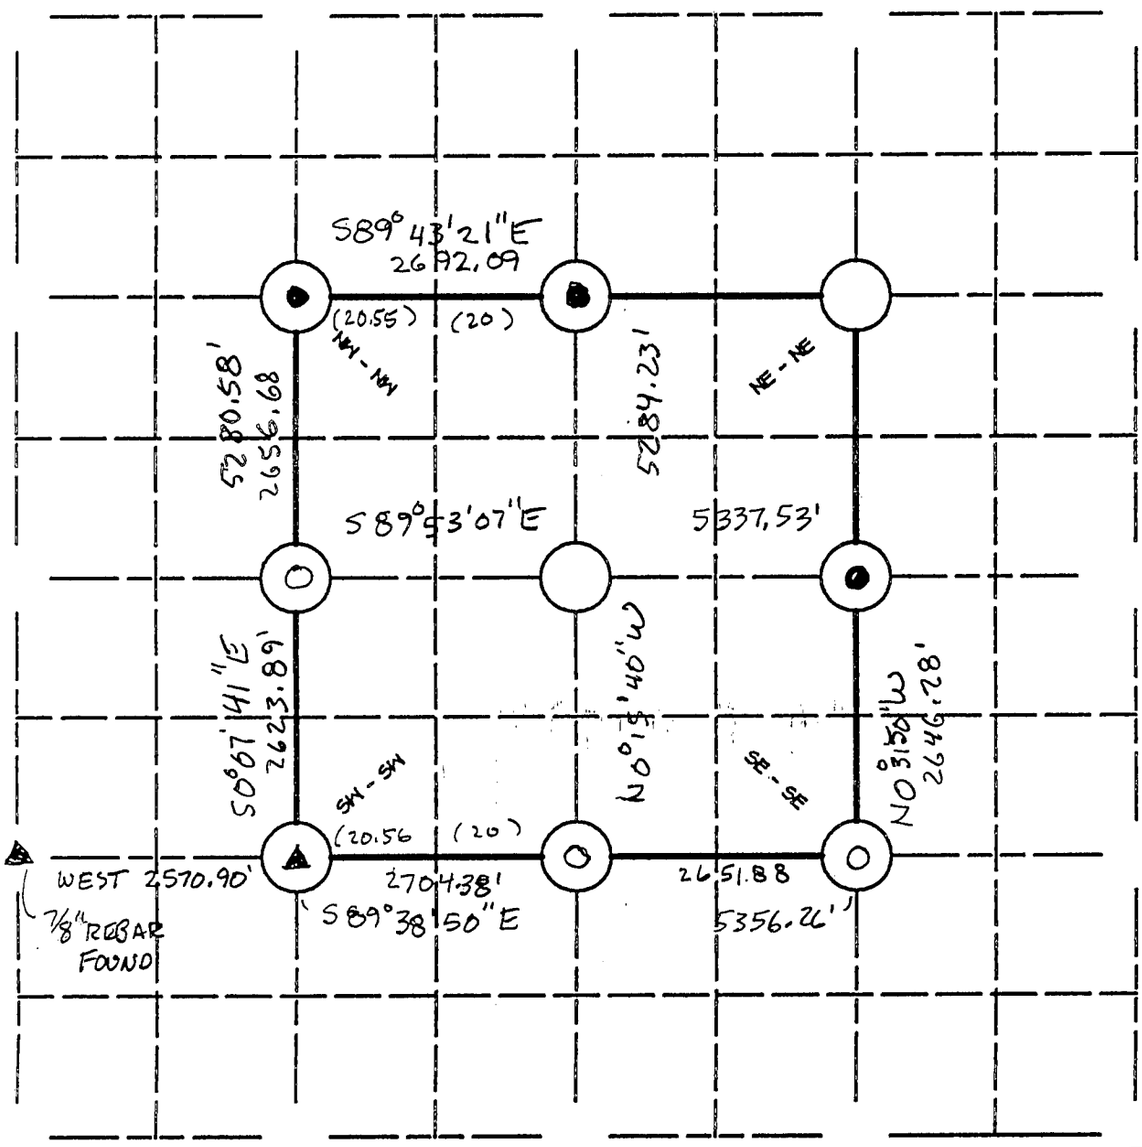

PLAT BEARINGS REFERENCED TO S LINE SE 1/4 13-7-3W WHICH LINE IS RECORDED AS BEARING E-W

ALUMCAPSET

LEGEND:

- ○ COUNTY MONUMENT SET 7/8"x24" REBAR W/GRANT CO.
- △ COUNTY MONUMENT FOUND
- OTHER(Specify)
- ▲ OTHER(Specify) 3/4" REBAR FOUND
- ● OTHER(Specify) FOUND 1 1/4" IRON PIPE
- ( ) OTHER(Specify) RECORDED AS
- OTHER(Specify)

SEAL

WISCONSIN
LAURENCE E. SCHMIT
S-1312
Dodgeville
Wis.
LAND SURVEYOR

Laurence E. Schmit 2-29-2000

SIGNATURE DATE

Horiz. Datum	The information provided in this box is not req'd, but requested to be provided if available to the surveyor preparing this sheet, otherwise provide reference in accord with survey plat related with to preparation of this sheet.
☐ NAD 27 ☐ NAD 83(91)	
Units ☐ ENGLISH ☐ Metric	
Co-ordinate System ☐ Geodetic ☐ State Plane(S. zone) ☐ GRANT County	X(easting) Lat Y(northing) Longit.