GRANT COUNTY
SECTION SUMMARY SHEET

SECTION 19 T 7 N R 2 ~~E~~ W

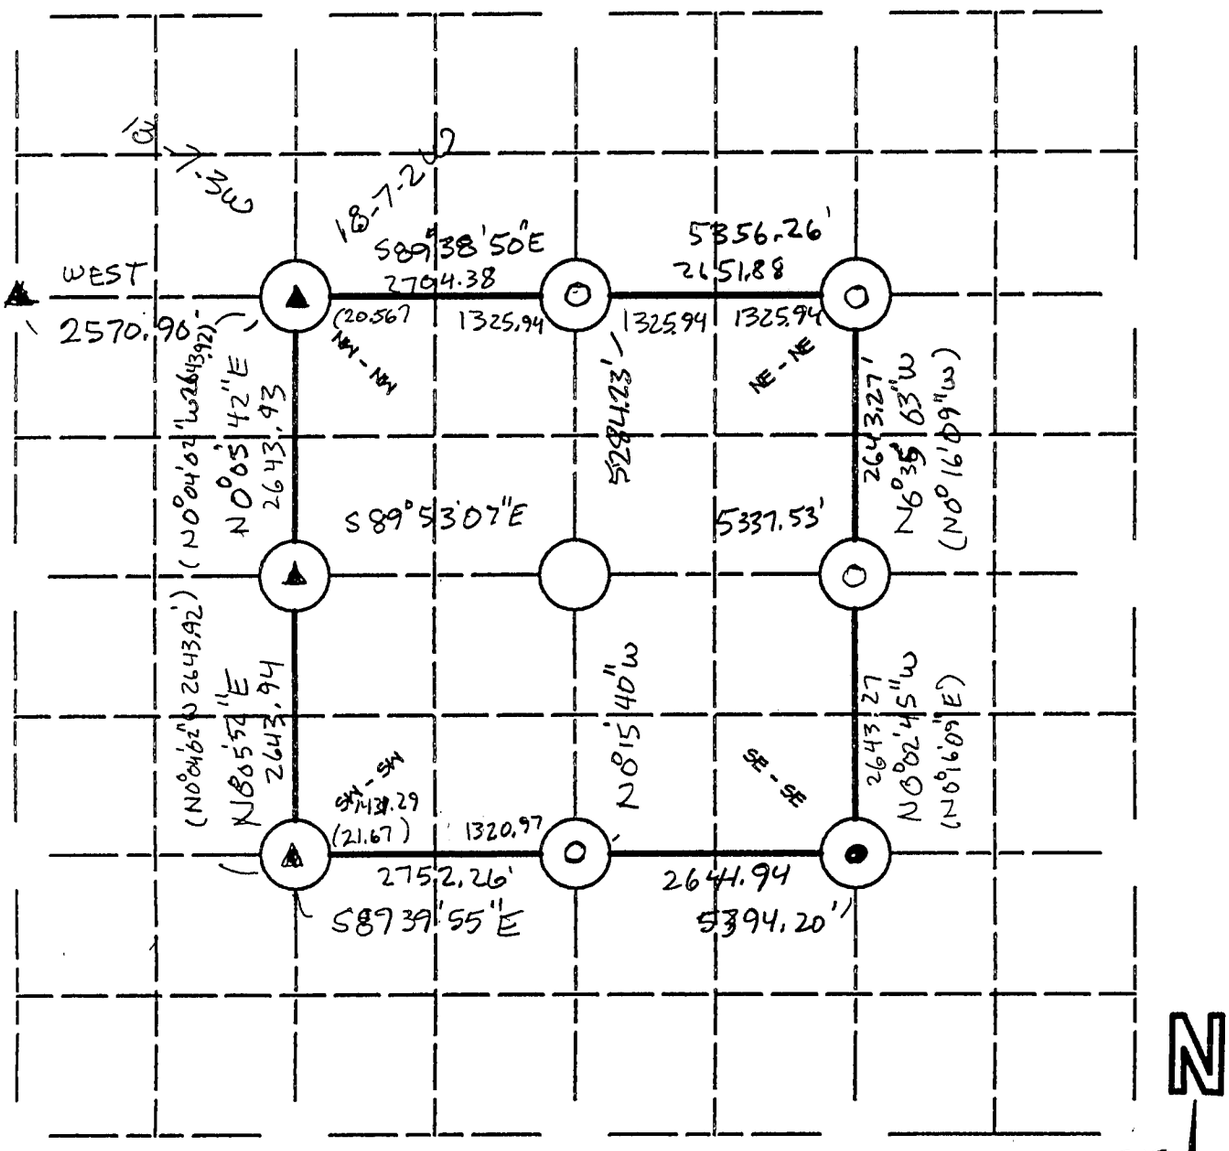

PLAT BEARINGS ARE REFERENCED TO THE S LINE OF THE SE 1/4 OF 13-7-3W WHICH LINE IS RECORDED AS BEARING E-W

LEGEND:

- ○ COUNTY MONUMENT SET 7/8"X24" REBAR SET WITH GRANT CO. ALUM CAP
- △ COUNTY MONUMENT FOUND
- OTHER(Specify)
- ▲ OTHER(Specify) 3/4" REBAR FOUND
- ● OTHER(Specify) FOUND 1 1/2" IRON PIPE
- ( ) OTHER(Specify) RECORDED AS
- OTHER(Specify)

SEAL

WISCONSIN
LAURENCE E. SCHMIT
S-1312
Dodgeville
Wis.
LAND SURVEYOR

Laurence E. Schmit 2-29-2000

SIGNATURE DATE

Horiz. Datum	The information provided in this box is not req'd, but requested to be provided if available to the surveyor preparing this sheet; otherwise provide reference in accord with survey plat related with to preparation of this sheet.
☐ NAD 27 ☐ NAD 83(91)	
Units ☐ ENGLISH ☐ Metric	
Co-ordinate System ☐ Geodetic ☐ State Plane(S. zone) ☐ GRANT County	X(easting) Lat Y(northing) Longit.