GRANT COUNTY
CERTIFIED LAND CORNER

CORNER NUMBER 38

CERTIFICATE:

I, Larry L. Austin, do hereby certify that on the 21st day of February, 2000, I found evidence of the West 1/4 corner of Section 11, Town 8 North, Range 1 West, of the 4th Principal Meridian, and I re-established said corner according to the Wisconsin statutes as shown and described hereon.

Dated this 23rd day of June, 2000

Larry L. Austin S-1903

WISCONSIN
LARRY L
AUSTIN
S-1903
LANCASTER
WI
LAND SURVEYOR

SEAL

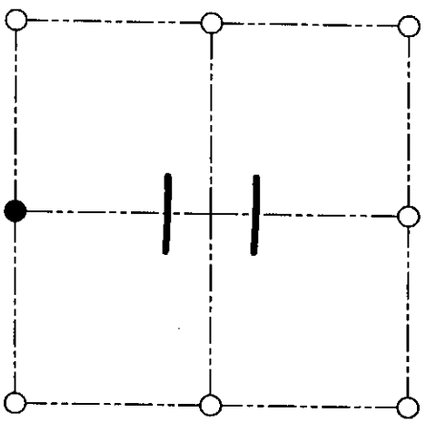

● = CORNER LOCATION

WEST 1/4 CORNER OF
SECTION 11, T 8 N R 1 W
TOWN OF MUSCODA

HISTORY OF ORIGINAL CORNER ESTABLISHMENT:

Corner was originally set in 1833 by Harvey Parke.
No other record of the corner was found.

DESCRIPTION OF CORNER EVIDENCE FOUND:

I found the Number 6 rebar at this location and
accepted it's location after an E.D.M. & G.P.S. traverse of the area.

DESCRIPTION OF CORNER AND WITNESS MONUMENTS, references and accessories used to perpetuate the original or re-established location of this corner

WITNESS TO THE CORNER LOCATION: SHANE AUSTIN & SHELBY BLINDERT & BOBBY SEDGWICK

SKETCH:

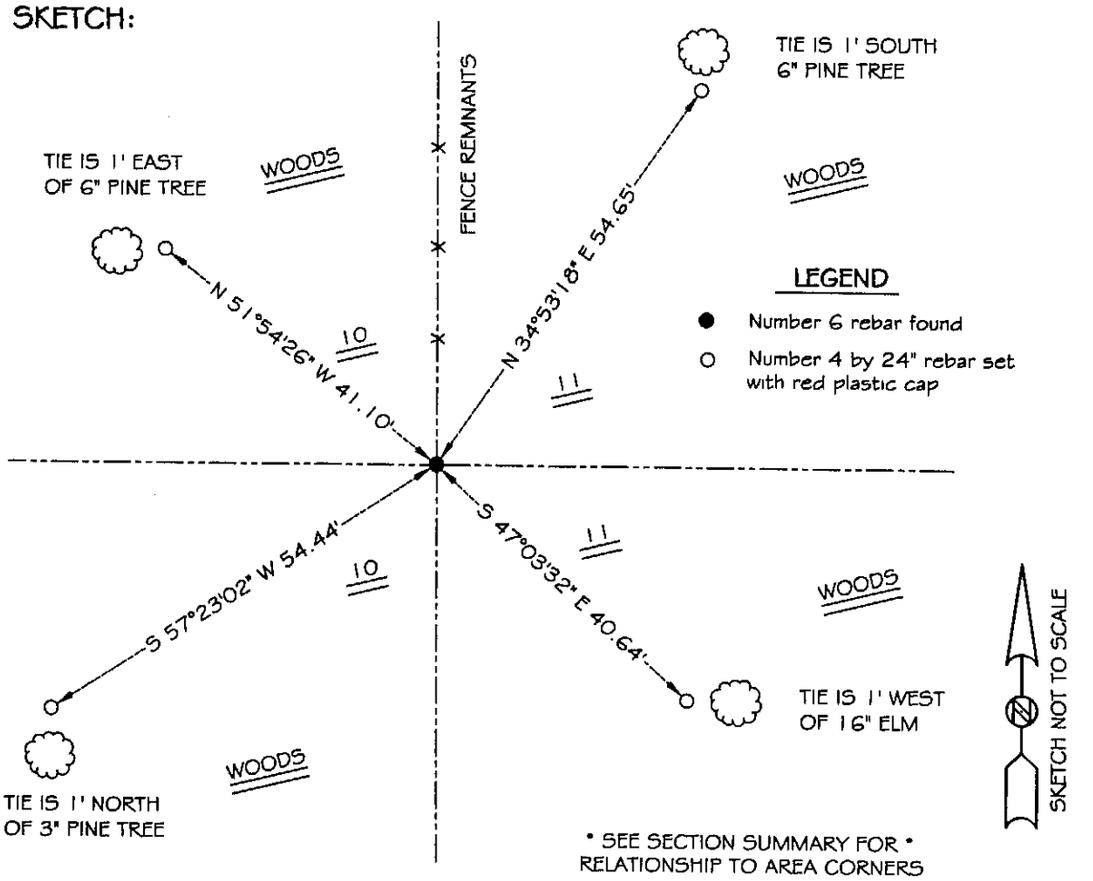

* SEE SECTION SUMMARY FOR *
RELATIONSHIP TO AREA CORNERS

C:\SC1-4\SW\ATTEST\8NR1W\38