U.S. PUBLIC LAND SURVEY MONUMENT RECORD

(AS REQUIRED BY s.A–E 7.08, WI. ADM. CODE)

HISTORY OF ORIGINAL CORNER ESTABLISHMENT AND SUBSEQUENT RESTORATIONS AND DESCRIPTION OF ANY RECORD, MONUMENT, OCCUPATION, TESTIMONIAL OR OTHER EVIDENCE CONSIDERED

NORTHING SET 1320.00' NORTH FROM FOUND 1–1/4" IRON PIPE AT FENCE CORNER FROM 1968 HOMER D. RALPH SURVEY, EASTING SET BY A STRAIGHT LINE BETWEEN SECTION CORNER TO NORTH AND SAID 1–1/4" IRON PIPE. I SET A 3/4" REBAR APPROXIMATELY 1.90' WEST OF THE CENTERLINE OF COUNTY ROAD "G".

BEARING REFERENCE IS GRANT COUNTY COORDINATE SYSTEM NAD 83(91)

CORNER WAS: (CHECK ALL THAT APPLY)

- ☐ RESTORED THROUGH ACCEPTANCE OF AN OBLITERATED EVIDENCE LOCATION
- ☐ RESTORED THROUGH ACCEPTANCE OF A FOUND PERPETUATED LOCATION
- ☒ CONSIDERED A LOST CONRER AND REESTABLISHED THROUGHT LOST CORNER PROPORTIONATE METHODS (INCLUDE A PLAN VIEW DRAWING SHOWING BEARING & DISTANCE TO OTHER PUBLIC LAND SURVEY CORNERS USED FOR PROPORTIONING AND DETERMINING THE CORNER LOCATION)
- ☐ RESTORED OR REESTABLISHED IN A LOCATION THAT DIFFERS FROM A PREVIOUS RESTORATION OR REESTABLISHMENT (INCLUDE A PLAN VIEW DRAWING AND INDICATE WHAT WAS SET AND/OR FOUND)

Describe the monument and accessories used to perpetuate the location of the corner. (include a plan view drawing and indicated what was set and/or found)

LEGEND:

- ○ 1/2" IRON ROD SET
- ● 3/4" REBAR SET
- SECTION CORNER 3/4" REBAR SET
- —x— EXISTING FENCELINE
- ▲ 1–1/4" IRON PIPE FOUND
- □ STONE FOUND

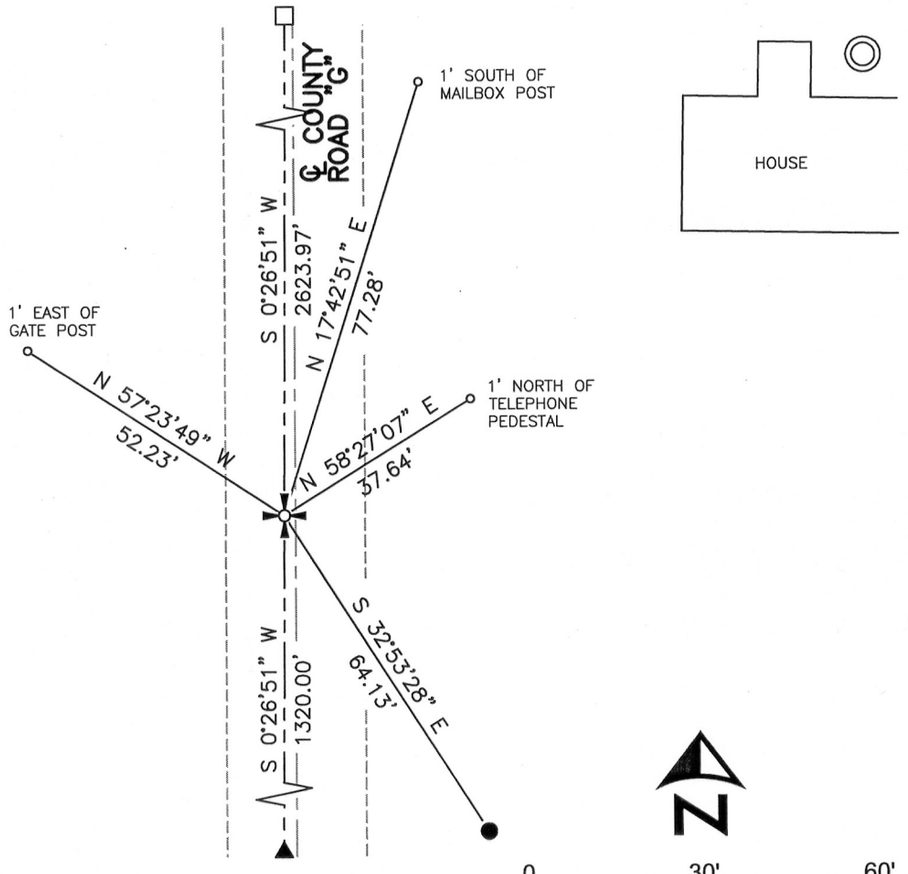

SECT 20		SECT 21	
TOWN 8N		TOWN 8N	
RANGE 1W		RANGE 1W	
SECT 29		SECT 28	
TOWN 8N		TOWN 8N	
RANGE 1W		RANGE 1W	

● = LOCATION OF CORNER

THE _____ COR. OF SECT 21 T 8N , R 1W

THE _____ COR. OF SECT 20 T 8N , R 1W

THE W1/4 COR. OF SECT 28 T 8N , R 1W

THE E1/4 COR. OF SECT 29 T 8N , R 1W

SW
SE

GRANT COUNTY, WISCONSIN

JOB ID: 1204101B

I, MICHAEL G. ROCHON, CERTIFY THAT THE CORNER LOCATION SHOWN ON THIS RECORD WAS DETERMINED BY ME OR UNDER MY DIRECTION AND CONTROL AND THAT THIS U.S. PUBLIC LAND SURVEY MONUMENT RECORD IS CORRECT AND COMPLETE TO THE BEST OF MY KNOWLEDGE AND BELIEF.

WISCONSIN
MICHAEL G. ROCHON
S-2767
DODGEVILLE
WIS.
LAND SURVEYOR

LAND SURVEYORS SEAL

Michael G. Rochon — 5/31/12

SIGNATURE — DATE:

INDEX NUMBER 109

SEP 14 2012