REC'D FEB 10 1997

Survey Monument Record

CORNER NO. _____
SECTION 11
TOWN 8N
RANGE 2W

TYPE OF MONUMENT 1" IRON PIPE
STATE PLANE COORDINATES: N _____
E _____
ELEVATION — M.S.L. DATUM: _____
THETA ANGLE: _____
FIELD BOOK: _____
PAGE _____

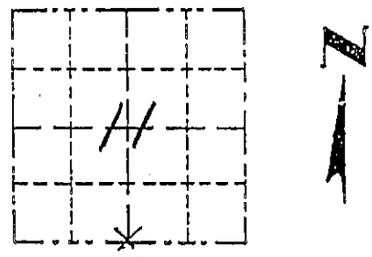

LOCATION
(Indicated by "X")

☐ FOUND PERPETUATED LOCATION
☒ OBLITERATED EVIDENCE LOCATION
☐ LOST CORNER (RESTORED BY PROPORTIONATE METHODS)

BASIS FOR MONUMENT LOCATION

(Use reverse side if necessary)

Show info such as: History of corner, with reference to Vol. and pg., dates, surveyor; exact description of monument replaced; if location computed, by taped or EDM traverse; landowner, remarks, etc.

There are no recent records of this corner. Physical evidence is a lons standing fenceline through the corner location. No evidence was found to determine the easting of the corner. The terrain is extremely hilly west and north of the corner and relativly flat east of the corner. The original goverment record distances were applied using the east line of the section and the east 1/2 of the south line to compute the easting of the corner.

CERTIFIED CORRECT TO THE BEST OF MY KNOWLEDGE AND BELIEF

Michael R. LaRosa
Registered Land Surveyor

DATE: 1/21/1997

TIE SKETCH

Show at least (4) ties and monument

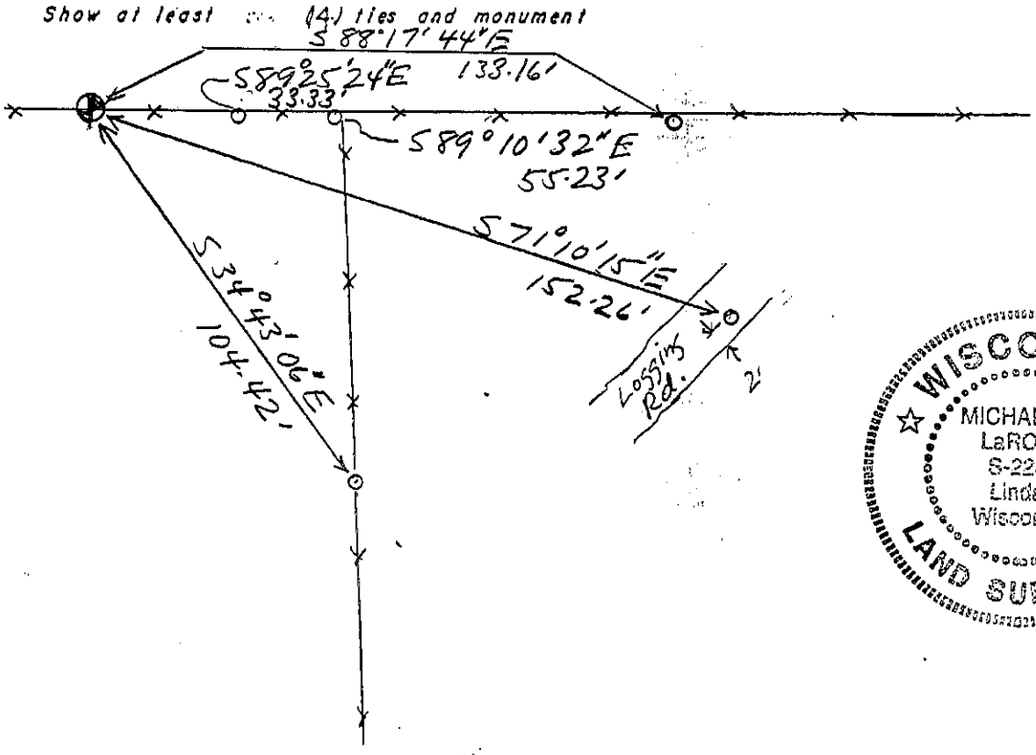

1" = 40'±

Legend

o 1/2" IRON PIPE

fence

WISCONSIN
MICHAEL R. LaROSA
S-2259
Linden
Wisconsin
LAND SURVEYOR