U.S. PUBLIC LAND SURVEY MONUMENT RECORD

GRANT COUNTY, WISCONSIN

SECTION 12 TOWNSHIP 1N RANGE 2W CORNER CENTER

EVIDENCE: NONE

MONUMENT: Found ☐ Placed ■

METHOD: Accepted Existing Location ☐
Accepted Occupation ☐
Lost Corner Porportionate Methods ☐

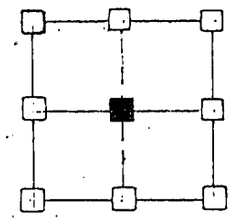

■ = Corner Location

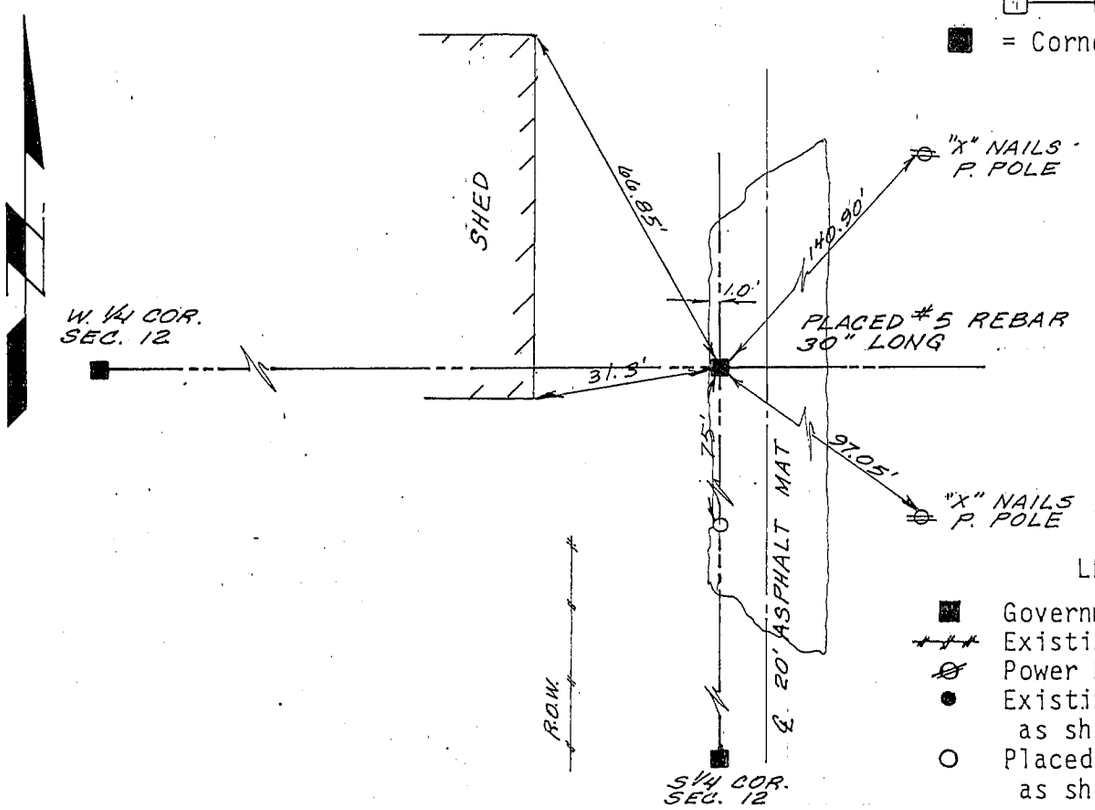

LEGEND

- ■ Government Corner
- Existing Fence Lines
- Power Pole
- ● Existing Iron Pipe as shown
- ○ Placed Rebar as shown

HISTORY & OTHER INFORMATION: CORNER SET BY SUBDIVIDING SECTION.

I, WARNER WRIGHT, hereby certify that the corner location shown hereon this record was determined by me or under my direction and control and that this U.S. Public Land Survey Monument Record is correct and complete to the best of my knowledge and belief.

WISCONSIN
WARNER R. WRIGHT
S-861
DUBUQUE
IOWA
LAND SURVEYOR

12-16-87
Date

Warner R. Wright
Registered Land Surveyor
No. 861

WI ASSOCIATES P.C.
3210 St Joseph Dr., R.R.#2 • Dubuque, IA 52001 • (319) 556-2484
P.O Box 275 • Galena, IL 61036 • (815) 777-0359

Title	MONUMENT RECORD SEC. 12, T.1N, R2W., 4th P.M.		Sheet 1 of 1
Date	8-6-87	Scale 1" =30	Drawing No.
Drawn	S.M.D.	Field Book W1-1-85	
Reviewed	W. W.	Revision	

P395