U.S. PUBLIC LAND SURVEY MONUMENT RECORD – GRANT COUNTY, WI

Section 24, Town 1 North Range 2 West, Town of Jamestown

CERTIFICATE

I, Larry L. Austin, do hereby certify that the corner location on this record was determined by me and/or under my direct supervision and that this U.S. public land survey monument record is correct and complete to the best of my knowledge and belief.

Dated this 29th day of September, 2005

Larry L. Austin S-1903

WISCONSIN LARRY L. AUSTIN S-1903 LANCASTER WI LAND SURVEYOR

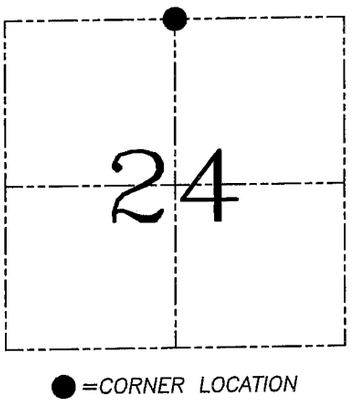

HISTORY OF CORNER ESTABLISHMENT

Corner was originally set in 1832 by Lyon.
No other record of the corner was found.

DESCRIPTION OF CORNER EVIDENCE FOUND

Corner was set proportionately between the Northwest and Northeast corners of this section and on–line with fence East. Verified this location using EDM & GPS methods.

DESCRIPTION OF CORNER AND WITNESS MONUMENTS, references and accessories used to perpetuate the original or re–established location of this corner. Witnesses to corner location Shelby Blindert & Brad Digman.

SKETCH:

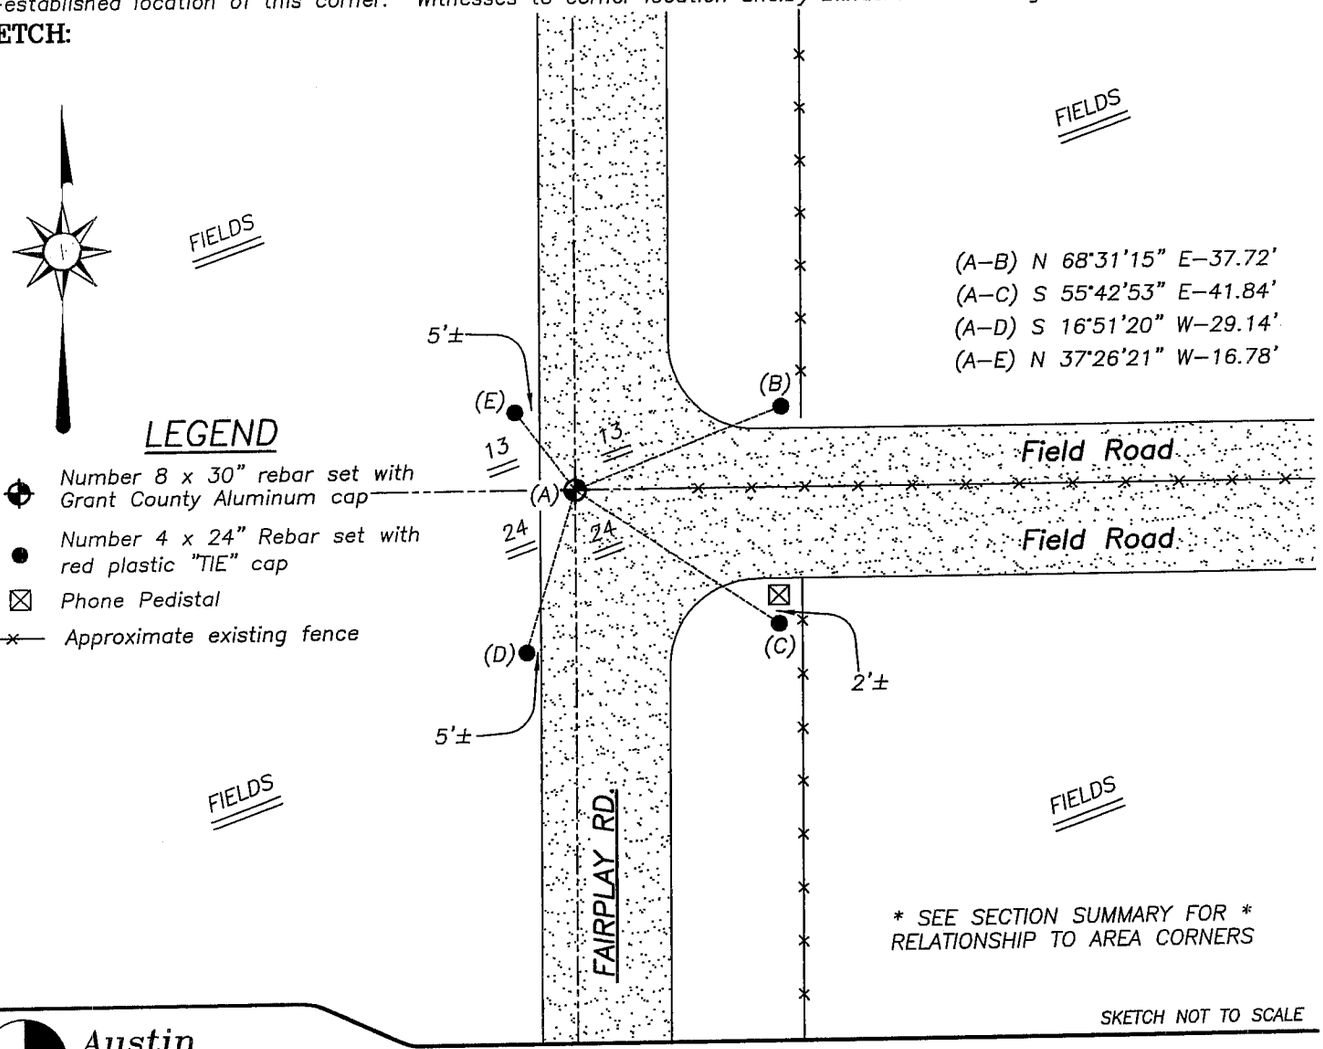

Austin Engineering LLC
4211 HWY 81 E, LANCASTER, WI 53813
PHONE 608–723–6363 FAX 608–723–6702

JOB NUMBER 05S233
FIELDBOOK: TDSR, 2510
G:\T1NR2W\13A
H:\TIE\T1NR2W\62

DRAWN BY: BJ HAZEN
APPROVED: LL AUSTIN