

GRANT COUNTY

Survey Monument Record

TYPE OF MONUMENT GRANT Co. Alum. Mon.

STATE PLANE COORDINATES: N _____
E _____

ELEVATION — M.S.L. DATUM: _____

THETA ANGLE: _____

FIELD BOOK: 94-18

PAGE 11


CORNER NO. 37

SECTION 9

TOWN 2 N

RANGE 1 W

E 1/4 COR

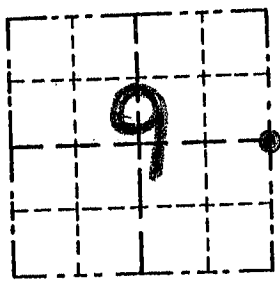

LOCATION
(Indicated by "•")


BASIS FOR MONUMENT LOCATION

(Use reverse side if necessary)

Show info such as: History of corner, with reference to Vol. and pg., dates, surveyor; exact description of monument replaced; if location computed, by taped or EDM traverse; landowner, remarks, etc.

SEAL:

NO RECORD OF CORNER
FD. SINCE ORIG SURVEYS; LOCATED
THE CORNER BASED ON OCCURATIONAL
EVIDENCE & VERIFIED BY EDM
TRAVERSE OF THE AREA.

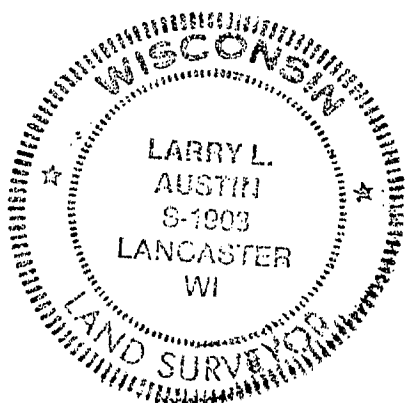

CERTIFIED CORRECT

Larry L. Austin
Registered Land Surveyor

DATE: 10/28/94

TIE SKETCH

Show at least three (3) ties and monument

