GRANT COUNTY

Survey Monument Record

CORNER NO. _____
SECTION 28
TOWN 2 N
RANGE 2 W

TYPE OF MONUMENT: 5/8" rebar found

STATE PLANE COORDINATES: (GRID) _____

ELEVATION – M.L.S. DATUM: _____

THETA ANGLE: _____ SCALE FACTOR: _____

FIELD BOOK: P-224 PAGE: 44

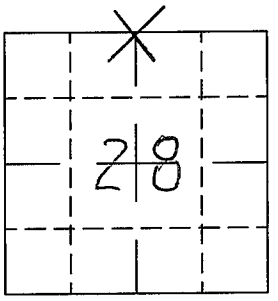

LOCATION (INDICATED BY 'X')

SEAL:

BASIS FOR MONUMENT LOCATION

(Use reverse side if necessary)

Show info such as: History of corner, with reference to Vol. and pg., dates, surveyor; exact description of monument replaced; if location computed, by taped or EDM traverse or if G.P.S.; land owner remarks, etc.

Found 5/8" rebar at fence corner

Accepted location and set 4 reference ties

WISCONSIN ANTHONY P. LULLOFF S-1655 KIEL, WI LAND SURVEYOR

CERTIFIED CORRECT:

Anthony P. Lulloff

Registered Land Surveyor

DATE: 5/15/00

TIE SKETCH

(Show at least four ties)

R.M. 1) 6" nail set in South face 10" ash ± 1' above ground level 13.79'

R.M. 2) 1" iron pipe set @ wood fence corner 14.75'

R.M. 3) " 16.49'
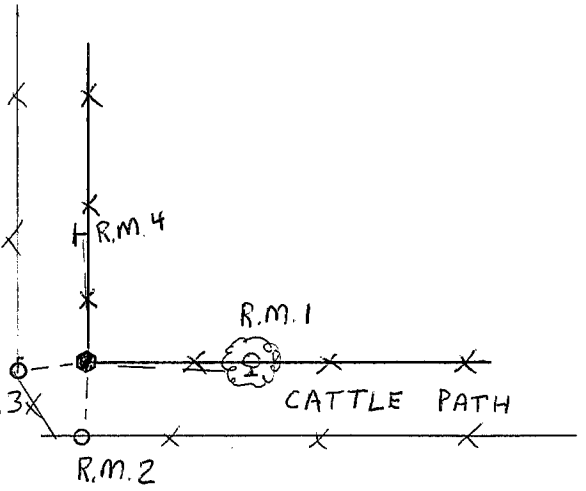
R.M. 4) Set 6" nail in west face of 1st Wood post North of corner, ± 1' above ground level 10.10'