U.S. PUBLIC LAND SURVEY MONUMENT RECORD – GRANT COUNTY, WI

Section 30, Town 2 North Range 2 West, Town of Paris

CERTIFICATE

I, Larry L. Austin, do hereby certify that the corner location on this record was determined by me and/or under my direct supervision and that this U.S. public land survey monument record is correct and complete to the best of my knowledge and belief.

Larry L. Austin, S–1903

WISCONSIN LARRY L. AUSTIN S-1903 LANCASTER WI LAND SURVEYOR

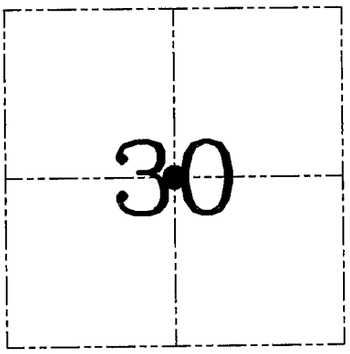

HISTORY OF CORNER ESTABLISHMENT

Corner was originally set in 1838 by the U.S. Army Corps of Engineers. No recent record of the corner was found.

DESCRIPTION OF CORNER EVIDENCE FOUND

I reestablished the corner based on the concrete monument found North of the corner.

DESCRIPTION OF CORNER AND WITNESS MONUMENTS, references and accessories used to perpetuate the original or re–established location of this corner. Witnesses to corner location Bobby Sedgwick & Brad Digman & Shane Austin

SKETCH:

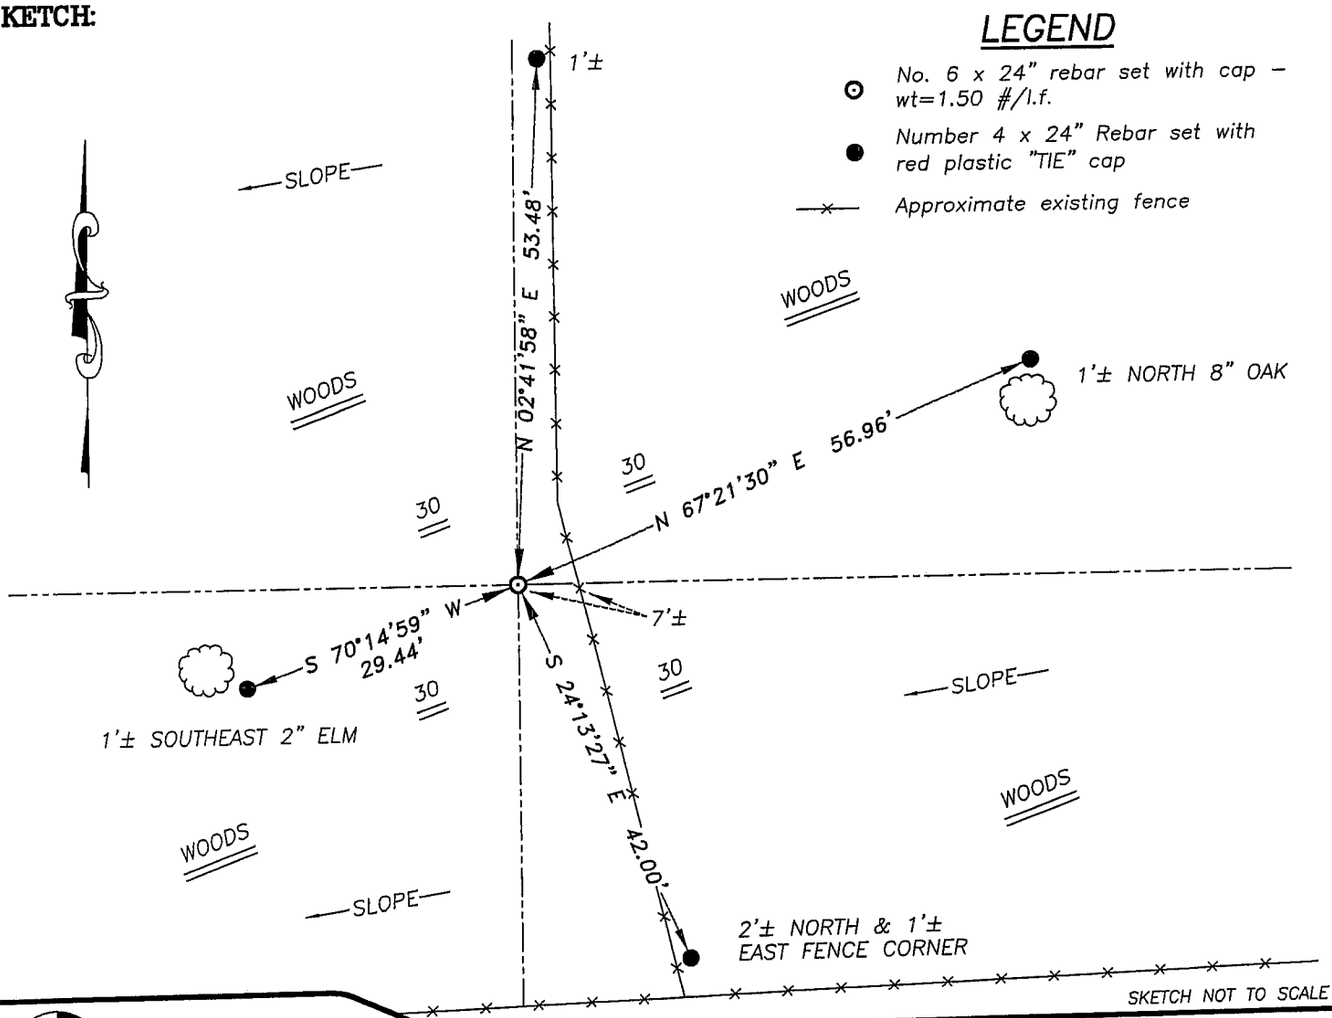

Austin Engineering LLC
4211 HWY 81 E, LANCASTER, WI 53813
PHONE 608–723–6363 FAX 608–723–6702

JOB NUMBER 07S031
FIELDBOOK: TDSR, 2700
G:\T2NR2W\23
H:\TIE\T2NR2W\94.5

DRAWN BY: SW AUSTIN
APPROVED: LL AUSTIN

94.5