U.S. PUBLIC LAND SURVEY MONUMENT RECORD – GRANT COUNTY, WI

Section 13, Town 2 North Range 3 West, Town of Potosi

CERTIFICATE

I, Larry L. Austin, do hereby certify that the corner location on this record was determined by me and/or under my direct supervision and that this U.S. public land survey monument record is correct and complete to the best of my knowledge and belief.

Dated this 22nd day of December, 2003

Larry L. Austin S–1903

WISCONSIN LARRY L. AUSTIN S-1903 LANCASTER WI LAND SURVEYOR

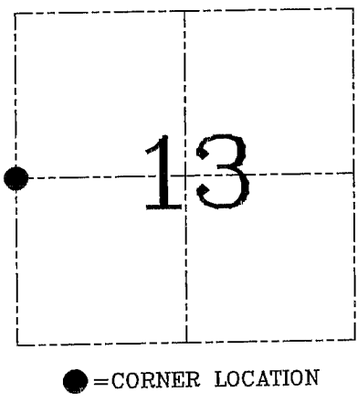

HISTORY OF CORNER ESTABLISHMENT

Corner was originally set in 1832 by Lyon. In 1876 Barber tied to the corner and set new bearing trees. In 1892 Sampson also tied to the corner.

DESCRIPTION OF CORNER EVIDENCE FOUND

I reset the corner proportionately between the Northwest and Southwest corners. This location fit occupational evidence at the corner and surrounding lines. Verified this location using EDM & GPS methods.

DESCRIPTION OF CORNER AND WITNESS MONUMENTS, references and accessories used to perpetuate the original or re–established location of this corner. Witnesses to corner location Bobby Sedgwick & Shelby Blindert & Brad Digman

SKETCH:

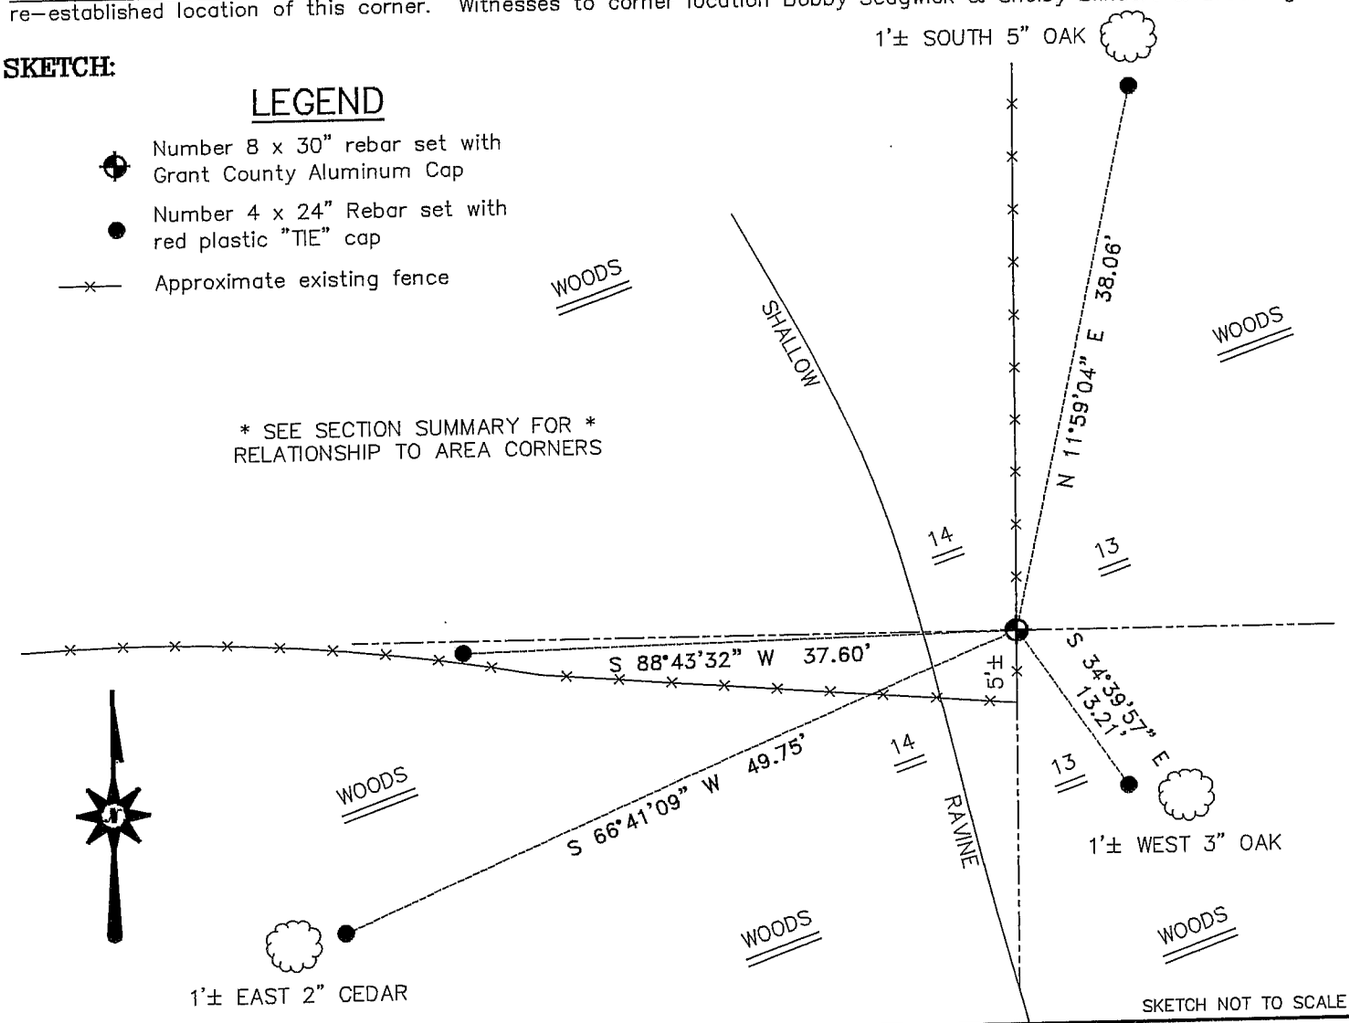

AUSTIN ENGINEERING, LLC
4211 HWY 81 EAST, LANCASTER, WI 53813
PHONE 608–723–6363 FAX 608–723–6702

FIELDBOOK: TDS RNGR, 2321
G:\T2NR3W\12
H:\TIE\T2NR3W\59
JOB NUMBER 03S288

DRAWN BY: SW AUSTIN
APPROVED: LL AUSTIN

CORNER NUMBER 59