U.S. PUBLIC LAND SURVEY MONUMENT RECORD – GRANT COUNTY, WI

Section 2, Town 2 North Range 1 West, Town of Smelser

CERTIFICATE

I, Larry L. Austin, do hereby certify that the corner location on this record was determined by me and/or under my direct supervision and that this U.S. public land survey monument record is correct and complete to the best of my knowledge and belief.

Dated this 10th day of August, 2004

Larry L. Austin S–1903

LARRY L. AUSTIN S-1903 LANCASTER WI LAND SURVEYOR

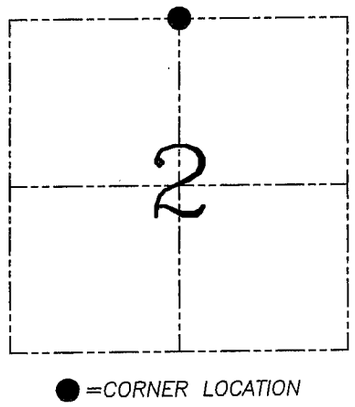

HISTORY OF CORNER ESTABLISHMENT

Corner was originally set in 1832 by Lucius Lyon. In 1855 Overton tied to the corner.

DESCRIPTION OF CORNER EVIDENCE FOUND

I was unable to locate any evidence of the original corner. I reset the corner based on a single proportion between the Northwest and Northeast corners of this section. Verified this location using EDM & GPS methods.

DESCRIPTION OF CORNER AND WITNESS MONUMENTS, references and accessories used to perpetuate the original or re–established location of this corner. Witnesses to corner location Bobby Sedgwick & Shelby Blindert & Brad Digman

SKETCH:

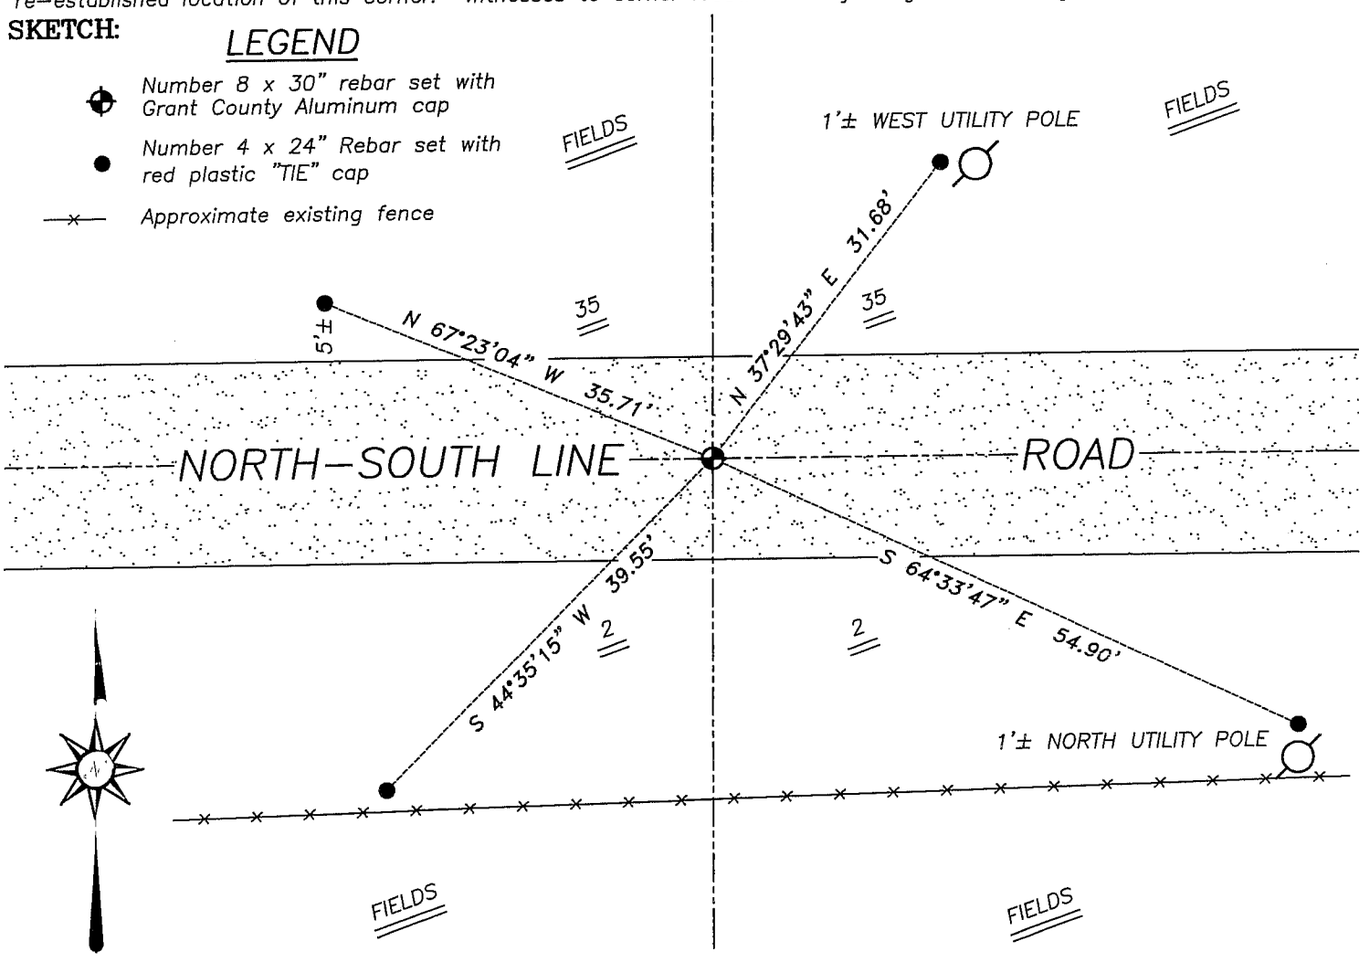

* SEE SECTION SUMMARY FOR * RELATIONSHIP TO AREA CORNERS

SKETCH NOT TO SCALE

Austin Engineering LLC
4211 HWY 81 E, LANCASTER, WI 53813
PHONE 608–723–6363 FAX 608–723–6702

JOB NUMBER 04S148
FIELDBOOK: TSDR, 2406
G:\T3NR1W\23
H:\TIE\T2NR1W\04

DRAWN BY: SW AUSTIN
APPROVED: LL AUSTIN