

Survey Monument Record

CORNER NO. 57  
 SECTION 15  
 TOWN 3N  
 RANGE 2W

TYPE OF MONUMENT 3/4" X 24" IRON BAR SET


STATE PLANE COORDINATES: N \_\_\_\_\_  
 E \_\_\_\_\_

ELEVATION -- M.S.L. DATUM: \_\_\_\_\_

THETA ANGLE: \_\_\_\_\_

FIELD BOOK: 97-19

PAGE (12)

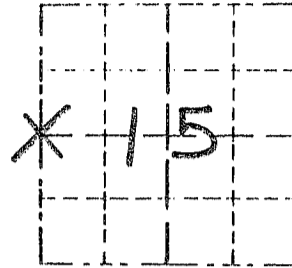


LOCATION  
 (Indicated by "X")

BASIS FOR MONUMENT LOCATION

(Use reverse side if necessary)

CORNER SET IN 1833 BY ROBERT CLARK. (NO RECOPIES OF CORNER FOUND SINCE ORIGINAL SURVEY; CORNER WAS SET AT AN OCCUPIED FENCE CORNER. VERIFIED THIS LOCATION USING E.B.M. METHODS.)

SEAL:

 

CERTIFIED CORRECT

*Randy R. Cant*  
 Registered Land Surveyor

DATE: 2/1/98

TIE SKETCH

Show at least three (3) ties and monument

LEGEND

- 3/4" X 24" IRON BAR SET
- 1/2" X 15" IRON BAR SET
- \* EXISTING FENCE

