GRANT COUNTY
CERTIFIED LAND CORNER

CORNER NUMBER 82

CERTIFICATE:

I, Larry L. Austin, do hereby certify that on the 20th day of July, 2000, I found evidence of the South 1/4 corner of Section 24, Town 3 North, Range 2 West, of the 4th Principal Meridian, and I re-established said corner according to the Wisconsin statutes as shown and described hereon.

Dated this 8th day of November, 2000

Larry L. Austin S-1903

Grant County Coor.

N 473780.3

E 861156.2

WISCONSIN
LARRY L. AUSTIN S-1903 LANCASTER WI
LAND SURVEYOR

SEAL

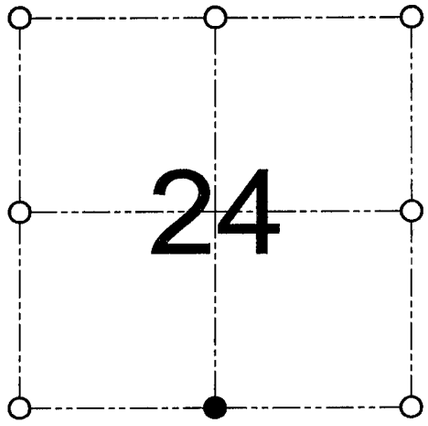

● = CORNER LOCATION

SOUTH 1/4 CORNER OF
SECTION 24, T 3 N R 2 W
TOWN OF HARRISON

HISTORY OF ORIGINAL CORNER ESTABLISHMENT:

Corner was originally set in 1833 by Clark.
No other record of the corner was found.

DESCRIPTION OF CORNER EVIDENCE FOUND:

I found an existing Number 6 iron bar at this location.
I accepted it's location after an EDM & GPS traverse of the area.

DESCRIPTION OF CORNER AND WITNESS MONUMENTS, references and accessories used to perpetuate the original or re-established location of this corner

WITNESS TO THE CORNER LOCATION: SHANE AUSTIN & SHELBY BLINDERT & BOBBY SEDGWICK
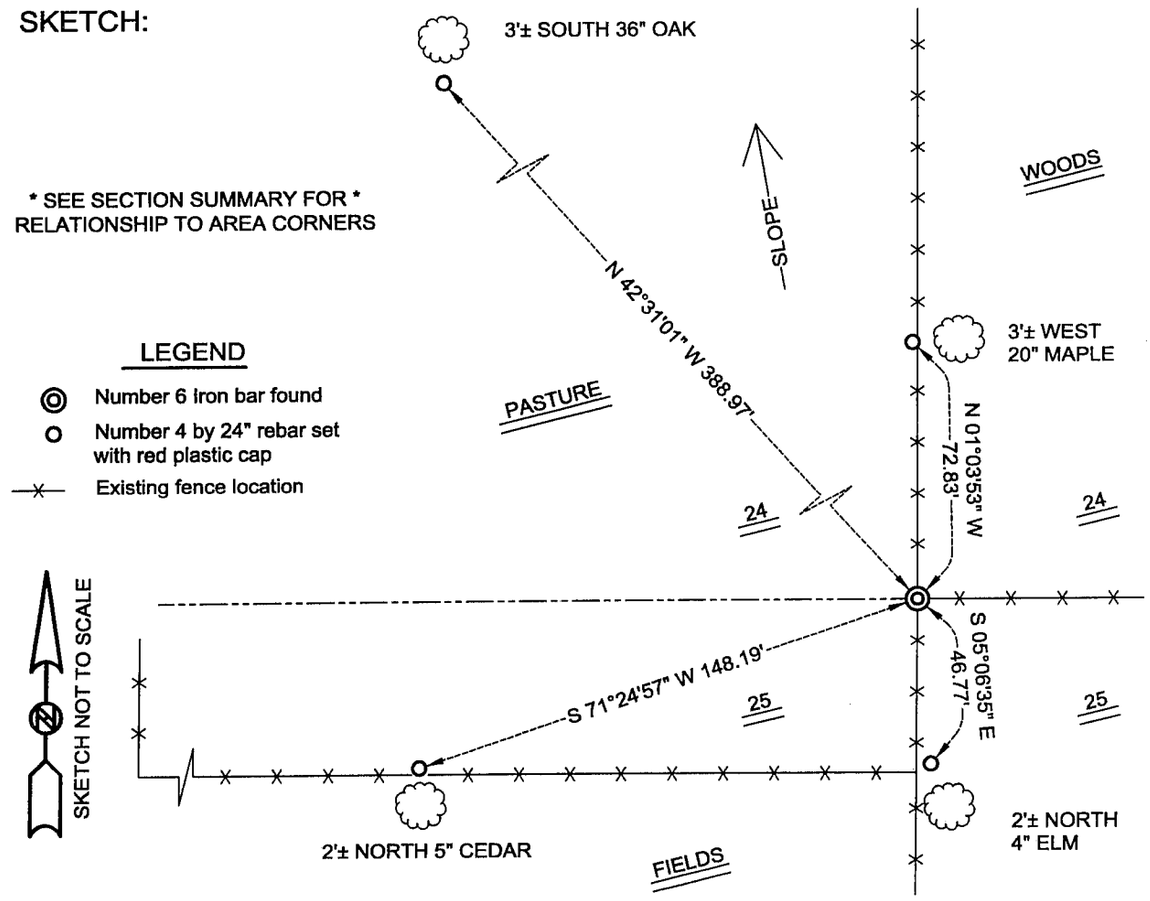
SKETCH: