GRANT COUNTY
CERTIFIED LAND CORNER

CORNER NUMBER 110

CERTIFICATE:

I, Larry L. Austin, do hereby certify that on the 23rd day of June, 2000, I found evidence of the South 1/4 corner of Section 29, Town 3 North, Range 4 West, of the 4th Principal Meridian, and I re-established said corner according to the Wisconsin statutes as shown and described hereon.

Dated this 28th day of July, 2000

Larry L. Austin S-1903

WISCONSIN
LARRY L. AUSTIN S-1903 LANCASTER WI
LAND SURVEYOR

SEAL

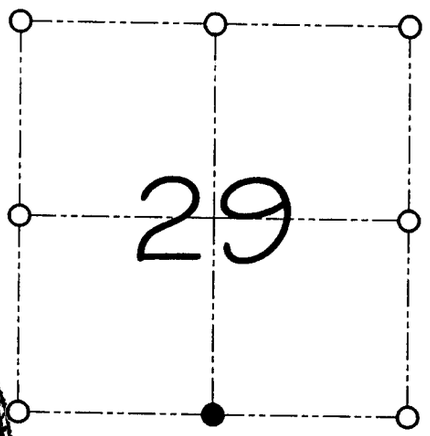

● = CORNER LOCATION

SOUTH 1/4 CORNER OF
SECTION 29, T 3 N R 4 W
TOWN OF WATERLOO

HISTORY OF ORIGINAL CORNER ESTABLISHMENT:

Corner was originally set in 1833 by Lucius Lyon.
In 1855 Overton tied to the corner. In 1881 J.C. Scott tied to the corner.

DESCRIPTION OF CORNER EVIDENCE FOUND:

I reset the corner online between the Southwest and Southeast corners of Section 29 for Northing. Easting was established by a North-South fence. Verified this location using EDM & GPS methods.

DESCRIPTION OF CORNER AND WITNESS MONUMENTS, references and accessories used to perpetuate the original or re-established location of this corner

WITNESS TO THE CORNER LOCATION: SHANE AUSTIN & JERRY SPEILMAN

SKETCH:

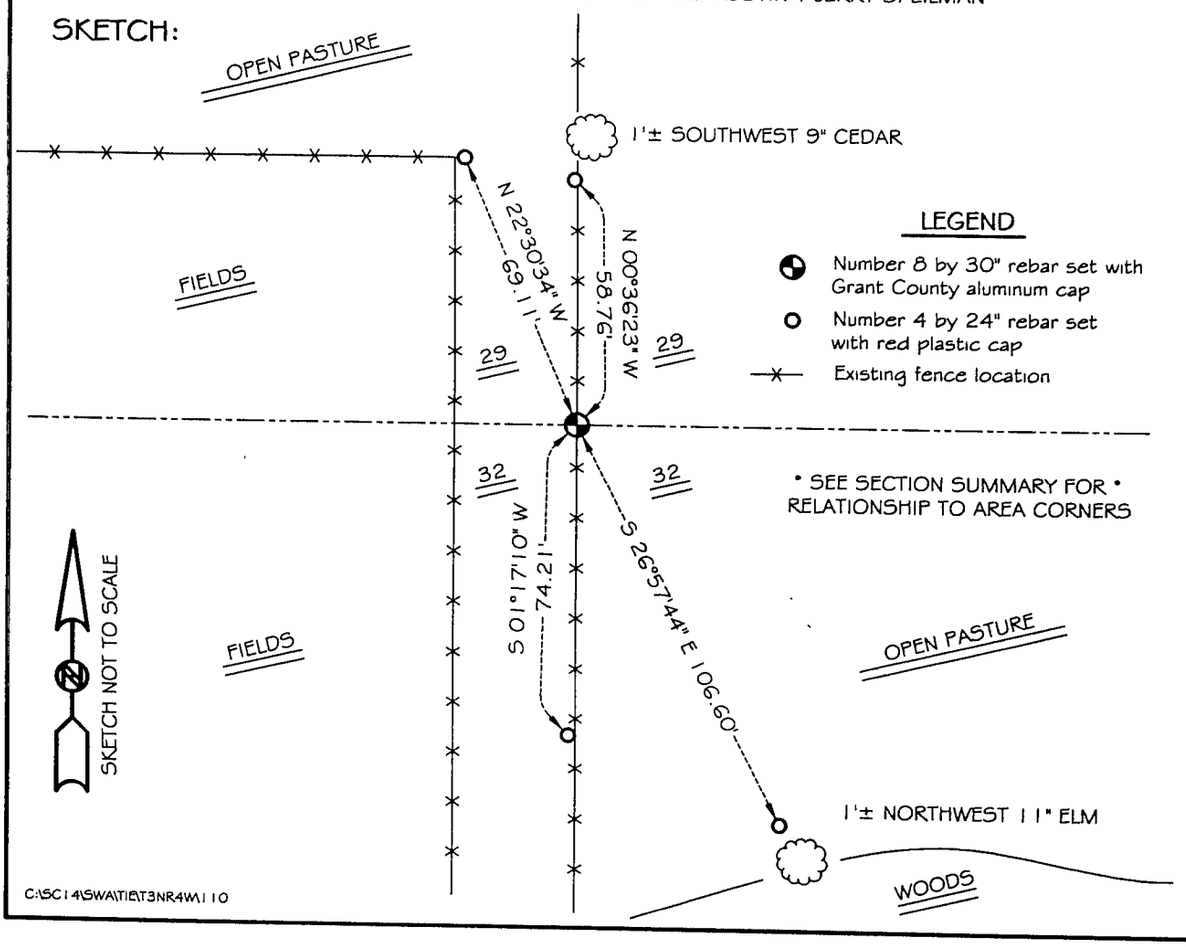

C:\SC14\SWA\TIE\T3NR4W\110