GRANT COUNTY
CERTIFIED LAND CORNER

CORNER NUMBER 97A

CERTIFICATE:

I, Larry L. Austin, do hereby certify that on the 11th day of July, 2000, I found no evidence of the Center of Section 27, Town 3 North, Range 4 West, of the 4th Principal Meridian, and I re-established said corner according to the Wisconsin statutes as shown and described hereon.

Dated this 28th day of July, 2000

Larry L. Austin S-1903

WISCONSIN
LARRY L. AUSTIN S-1903 LANCASTER WI
LAND SURVEYOR

SEAL

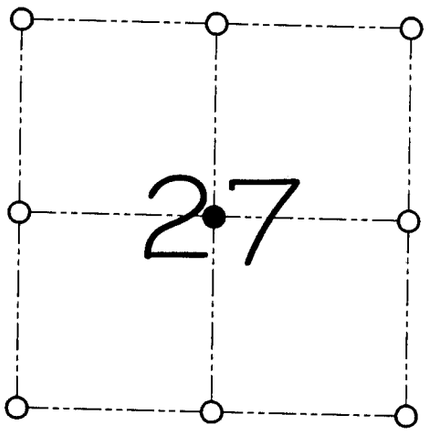

● = CORNER LOCATION

CENTER OF
SECTION 27, T 3 N R 5 W
TOWN OF CASSVILLE

HISTORY OF ORIGINAL CORNER ESTABLISHMENT:

Corner was never originally set.
In 1983 Matthew Janiak set a #6 Iron bar at this location.

DESCRIPTION OF CORNER EVIDENCE FOUND:

I found no evidence to the location of the #6 iron bar. I reset the corner at the intersection of the quarter lines. Verified this location using EDM & GPS methods.

DESCRIPTION OF CORNER AND WITNESS MONUMENTS, references and accessories used to perpetuate the original or re-established location of this corner

WITNESS TO THE CORNER LOCATION: SHELBY BLINDERT & BOBBY SEDGWICK

SKETCH:

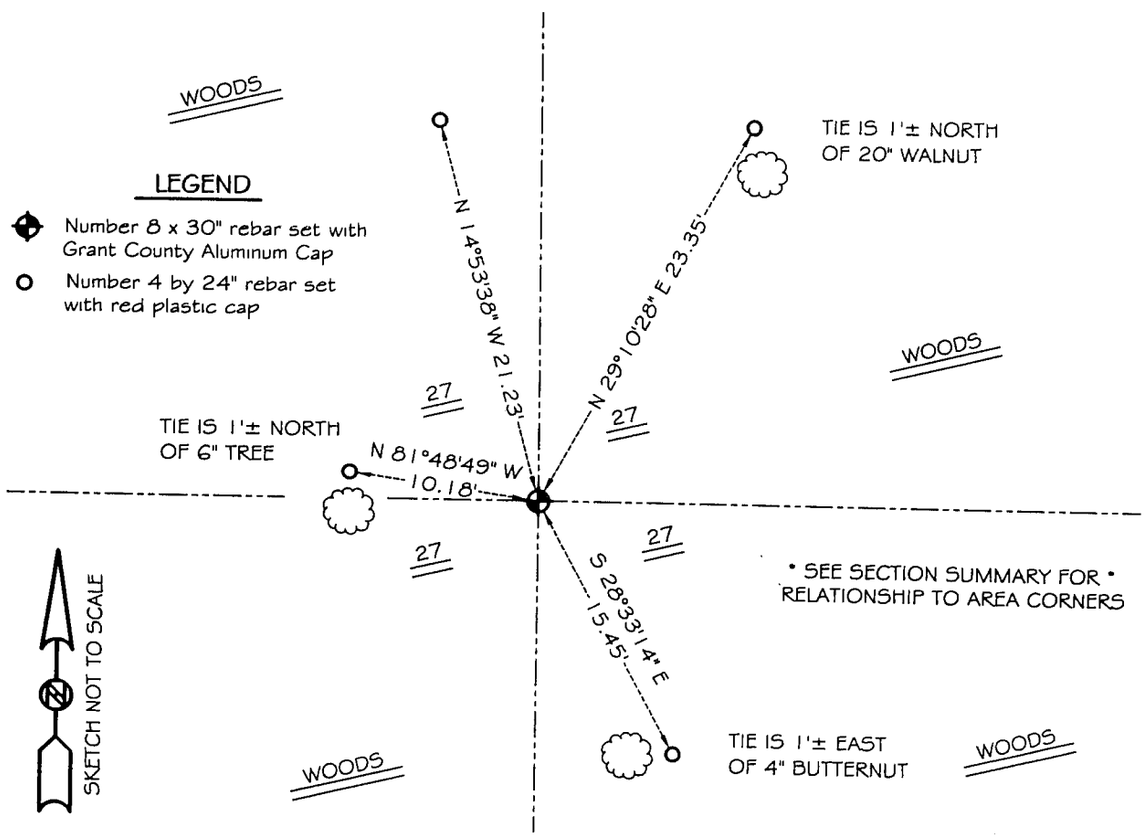

C:\SC141\SWA\TIE\T3NR4W\97A