U.S. PUBLIC LAND SURVEY MONUMENT RECORD

Section 5, Town 3 North Range 4 West, Town of Waterloo, Grant County, Wisconsin

CERTIFICATE

I, Larry L. Austin, do hereby certify that the corner location on this record was determined by me and/or under my direct supervision and that this U.S. public land survey monument record is correct and complete to the best of my knowledge and belief.

Larry L. Austin, S-1903 — date 4.19.09

WISCONSIN LARRY L. AUSTIN LANCASTER WI LAND SURVEYOR

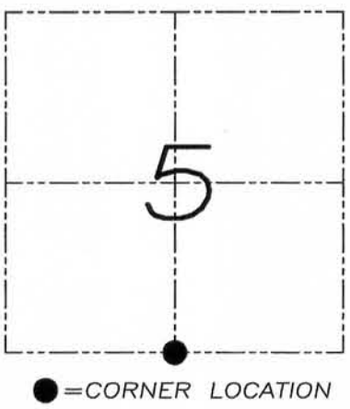

HISTORY OF CORNER

Corner was originally set in 1833 by Lucius Lyon. No other record of the corner was found.

CORNER EVIDENCE FOUND

I reset the corner by doubling the occupied South line of the SE 1/4, West of this location. This location fit other occupied and monumented corners in the area. I verified this location by using EDM and GPS methods.

DESCRIPTION OF CORNER AND WITNESS MONUMENTS, references and accessories used to perpetuate the original or re-established location of this corner. Witnesses to monument location Bobby Sedgwick & Brad Digman & Shelby Blindert

SKETCH:

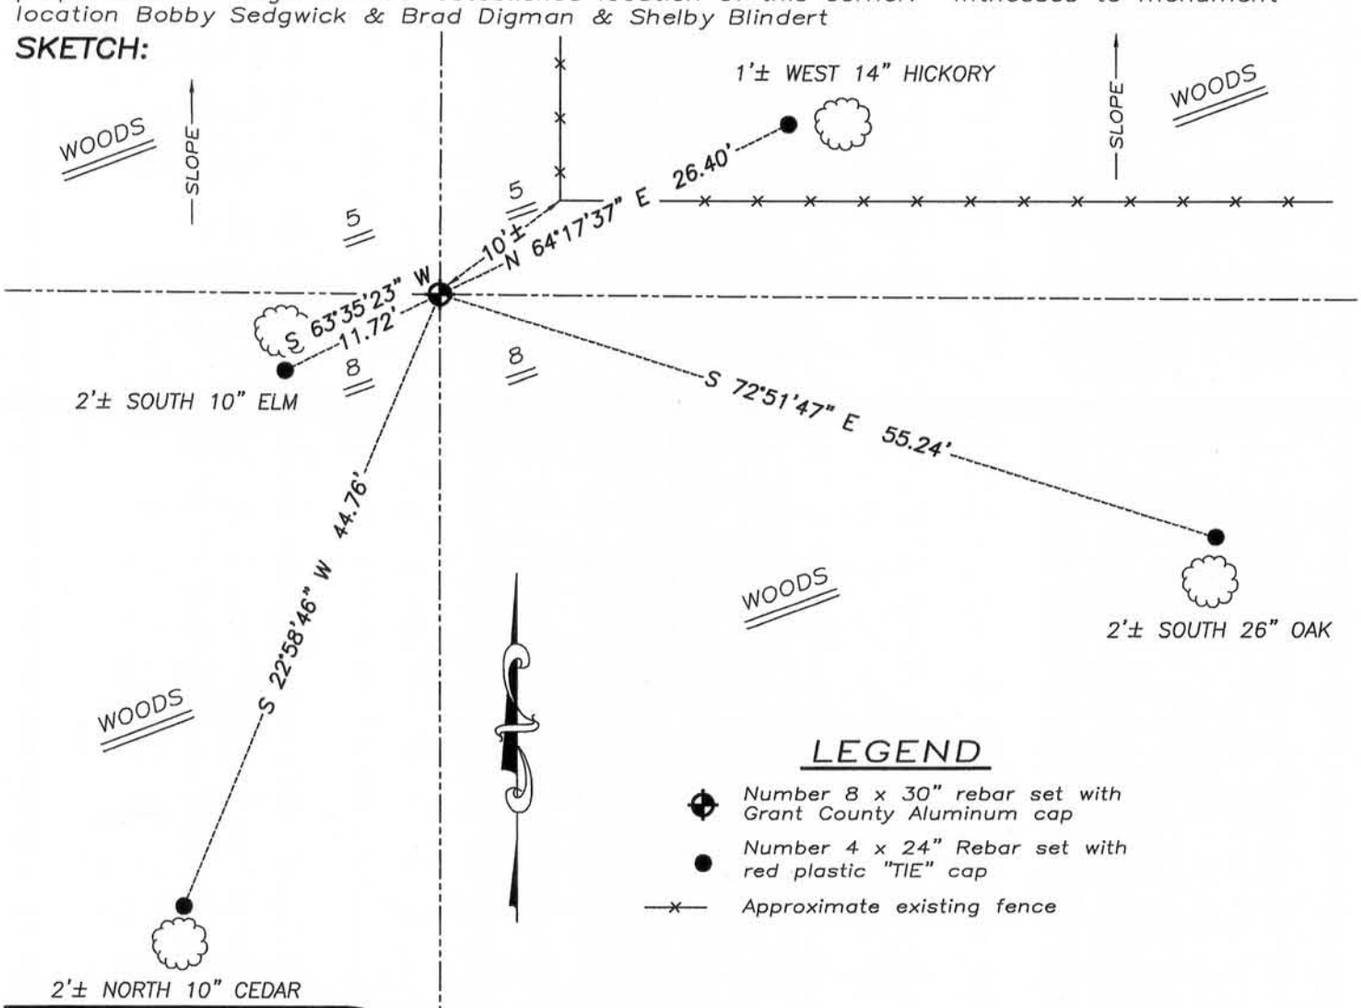

NOT TO SCALE

Austin Engineering LLC
4211 HWY 81 E, LANCASTER, WI 53813
PHONE 608-723-6363 FAX 608-723-6702

JOB NUMBER 08S294-RAGATZ
FIELDBOOK: TDSR, 2802
G:\T4NR4W\33
H:\TIE\T3NR4W\30

DRAWN BY: SW AUSTIN
APPROVED: LL AUSTIN

30

DEC 14 2011