

GRANT COUNTY

Survey Monument Record


TYPE OF MONUMENT 7/8" x 24" REBAR
 STATE PLANE COORDINATES: N _____
 E _____
 ELEVATION — M.S.L. DATUM: _____
 THETA ANGLE: _____
 FIELD BOOK: _____
 PAGE _____

CORNER NO. 25
 SECTION 11
 TOWN 4 N
 RANGE 1 W
NW COR.

BASIS FOR MONUMENT LOCATION


(Use reverse side if necessary)

Show info such as: History of corner, with reference to Vol. and pg., dates, surveyor; exact description of monument replaced; if location computed, by taped or EDM traverse; landowner, remarks, etc.

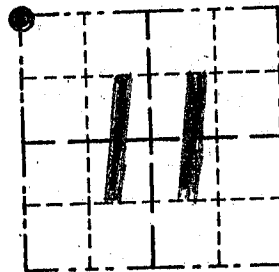

LOCATION
(Indicated by "●")

SEAL:

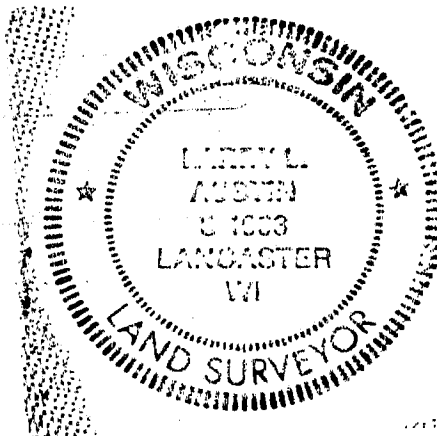

LAST RECORD OF COR. WAS FOUND ON HWY PLAN FOR C.T.H. "A" - PROJ 50 917(4). SET THE CORNER BASED ON THIS LOCATION VERIFIED BY EDM TRAVERSE

CERTIFIED CORRECT

Larry L. Austin
 Registered Land Surveyor

DATE: 10/5/94

TIE SKETCH

Show at least three (3) ties and monument

