GRANT COUNTY
CERTIFIED LAND CORNER

CERTIFICATE:

I, LARRY L. AUSTIN, DO HEREBY CERTIFY THAT ON SIXTH DAY OF MAY, 1999, I FOUND NO EVIDENCE OF THE SOUTH 1/4 CORNER OF SECTION 16, TOWN 4 NORTH, RANGE 1 WEST, OF THE FOURTH PRINCIPAL MERIDIAN, AND I RE-ESTABLISHED SAID CORNER ACCORDING TO THE WISCONSIN STATUTES AS SHOWN AND DESCRIBED HEREON.

DATED THIS FIFTH DAY OF JULY, 1999

LARRY L. AUSTIN S-1903

WISCONSIN
LARRY L.
AUSTIN
S-1903
LANCASTER
WI
LAND SURVEYOR

SEAL

CORNER NUMBER 68

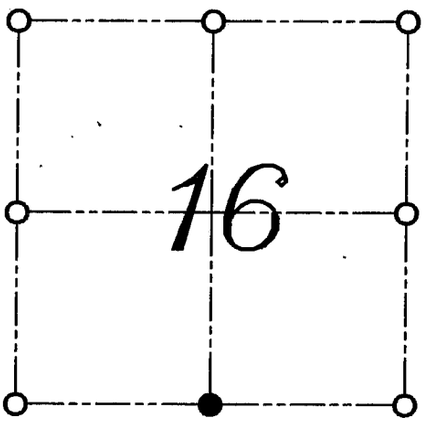

● = *CORNER LOCATION*

SOUTH 1/4 CORNER OF SECTION 16, T 4 N R 1 W TOWN OF LIMA

HISTORY OF ORIGINAL CORNER ESTABLISHMENT:

CORNER WAS SET IN 1833 BY ROBERT CLARK. NO OTHER SURVEY RECORDS OF THE CORNER WERE FOUND.

DESCRIPTION OF CORNER EVIDENCE FOUND:

I SET THE CORNER AT A SINGLE PROPORTION ALONG THE SOUTH LINE OF SECTION 16. VERIFIED THIS LOCATION USING E.D.M. AND G.P.S. METHODS.

DESCRIPTION OF CORNER AND WITNESS MONUMENTS, REFERENCES AND ACCESSORIES USED TO PERPETUATE THE ORIGINAL OR RE-ESTABLISHED LOCATION OF THIS CORNER: WITNESS TO THE CORNER LOCATION: BOBBY SEDGWICK ; SHELBY BLINDERT

SKETCH:

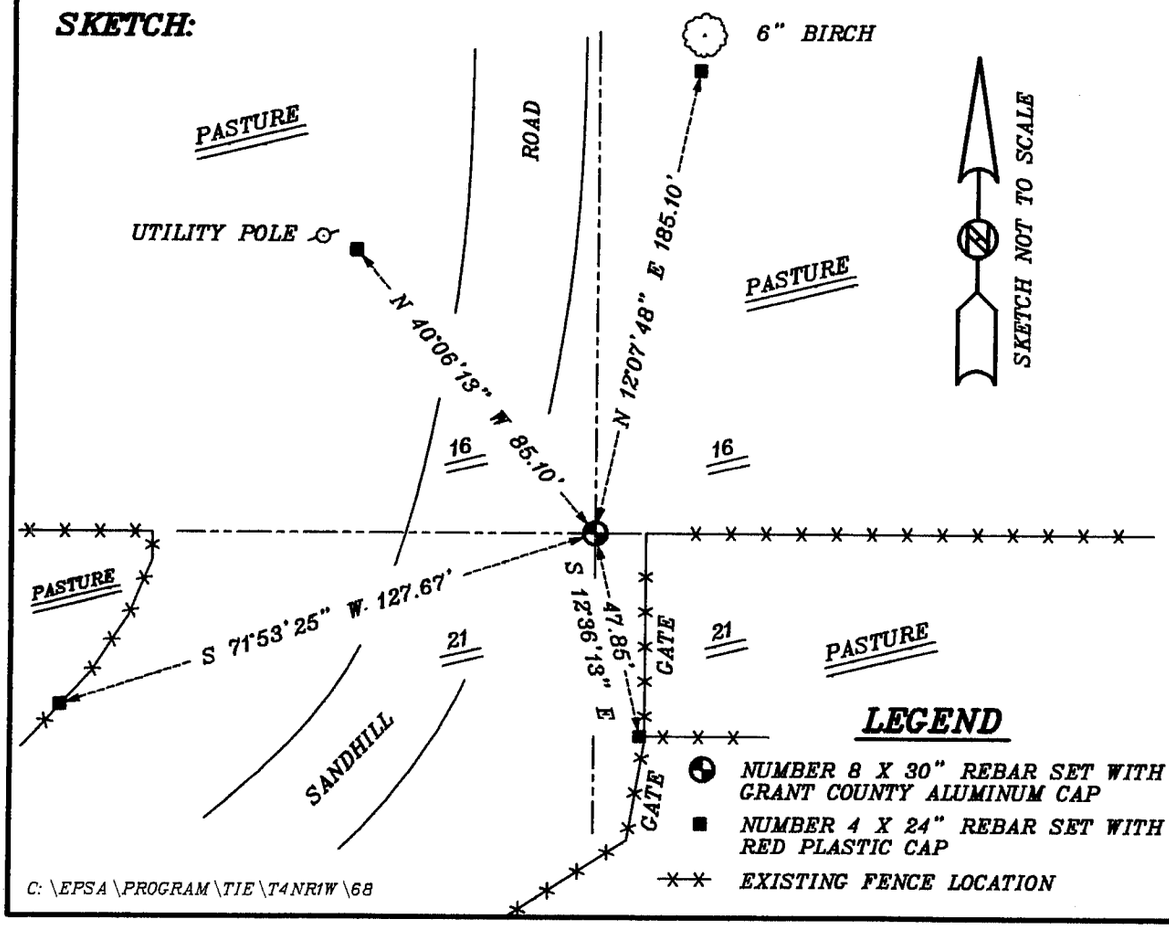

C: \EPSA \PROGRAM \TIE \T4NR1W \68

AUG 10 1999