


Survey Monument Record

TYPE OF MONUMENT 3/4" x 24" IRON
BAR SET

CORNER NO. _____
 SECTION _____
 TOWN _____
 RANGE _____

FIELD BOOK: 96-08
 PAGE (18)

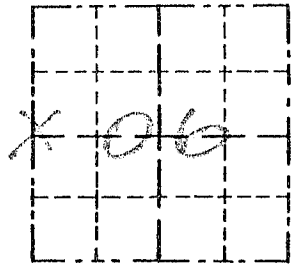


BASIS FOR MONUMENT LOCATION

(Use reverse side if necessary)
 Show info such as: History of corner, with reference to Vol. and pg., dates, surveyor; exact description of monument replaced; if location computed, by taped or EDM traverse; landowner, remarks, etc.

SEAL:

IN 1876 JOEL BARBER MEASURED TO THE CORNER & TIED TO A COTTONWOOD TREE, THE TREE WAS NOT LOCATED. CORNER WAS SET AT THE OFFSET FROM THE EAST 1/4 CORNER OF SECTION 1, T4N R2W. VERIFIED THIS LOCATION USING EDM METHODS.

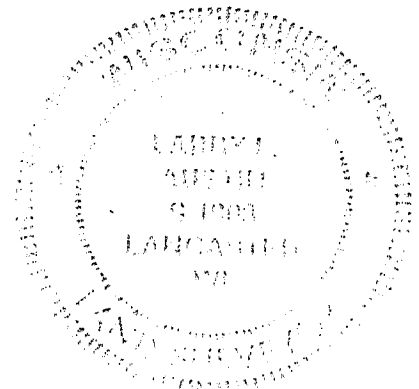

CERTIFIED CORRECT
Randy E. Ernst
 Registered Land Surveyor
 DATE: 1-16-98

TIE SKETCH

Show at least three (3) ties and monument

- LEGEND
 ⊕ 3/4" x 24" IRON BARSET
 ○ 1/2" x 15" IRON BARSET
 X X EXISTING FENCE

