GRANT COUNTY
CERTIFIED LAND CORNER

CORNER NUMBER 75

CERTIFICATE:

I, Larry L. Austin, do hereby certify that on the 5th day of May, 2000, I found evidence of the West 1/4 corner of Section 20, Town 4 North, Range 3 West, of the 4th Principal Meridian, and I re-established said corner according to the Wisconsin statutes as shown and described hereon.

Dated this 12th day of May, 2000

Larry L. Austin S-1903

WISCONSIN
LARRY L. AUSTIN S-1903 LANCASTER WI
LAND SURVEYOR

SEAL

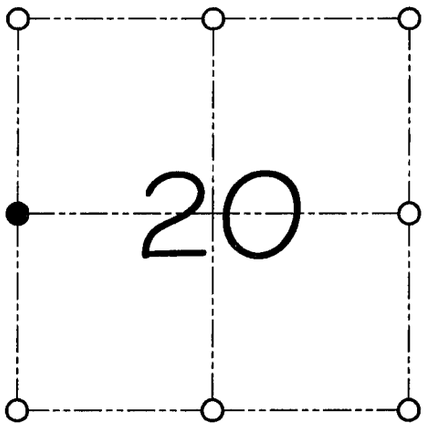

● = CORNER LOCATION

WEST 1/4 CORNER OF
SECTION 20, T 4 N R 3 W
TOWN OF SOUTH LANCASTER

HISTORY OF ORIGINAL CORNER ESTABLISHMENT:

Corner was originally set in 1833 by Robert Clark

DESCRIPTION OF CORNER EVIDENCE FOUND:

I found an existing fence corner and accepted it's location after an E.D.M. & G.P.S. traverse of the area.

DESCRIPTION OF CORNER AND WITNESS MONUMENTS, references and accessories used to perpetuate the original or re-established location of this corner

WITNESS TO THE CORNER LOCATION: SHANE AUSTIN & SHELBY BLINDERT

SKETCH:

• SEE SECTION SUMMARY FOR • RELATIONSHIP TO AREA CORNERS

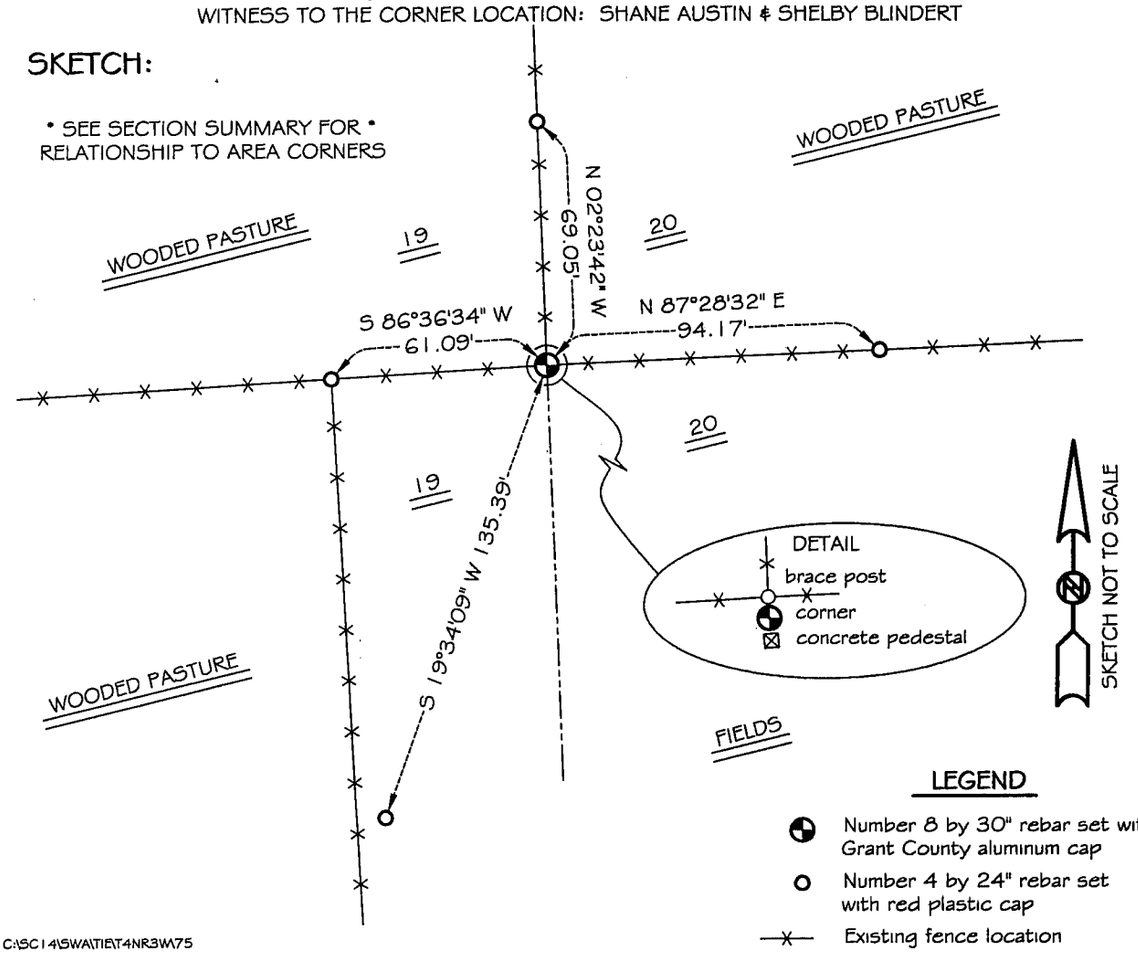

LEGEND

- Number 8 by 30" rebar set with Grant County aluminum cap
- Number 4 by 24" rebar set with red plastic cap
- Existing fence location

C:\SC14\SWA\TIE\T4NR3W75