U.S. PUBLIC LAND SURVEY MONUMENT RECORD - GRANT COUNTY, WI

Section 8, Town 4 North Range 4 West, Town of Beetown

CERTIFICATE:
I, Aaron J. Austin, do hereby certify that the corner location on this record was determined by me and/or under my direct supervision and that this U.S. Public Land Survey Monument Record is correct and complete to the best of my knowledge and belief.

Dated this 16th day of June, 2011.

Aaron J. Austin

Aaron J. Austin, S-2922

WISCONSIN AARON J. AUSTIN S-2922 LANCASTER WI LAND SURVEYOR

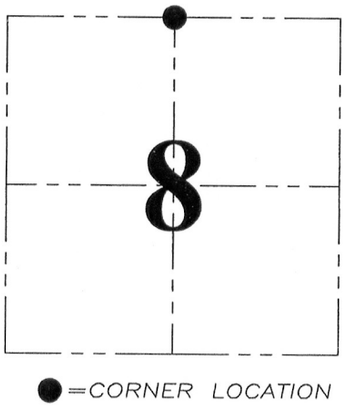

HISTORY OF CORNER ESTABLISHMENT:

Original corner set in 1832 by Clark. A survey was found in Book "A", Page 185 by Wiltse in 1844 for the South 1/2 of Section 8 and made no reference to this corner. No other record found of this corner.

DESCRIPTION OF CORNER EVIDENCE FOUND:

I set the monument at the occupied location of an existing fence corner and verfied this location by E.D.M. and G.P.S. methods.

DESCRIPTION OF CORNER AND WITNESS MONUMENTS, references and accessories used to perpetuate the original or re-established location of this corner. Witnesses to corner location Bobby Sedgwick & Shelby Blindert

SKETCH:

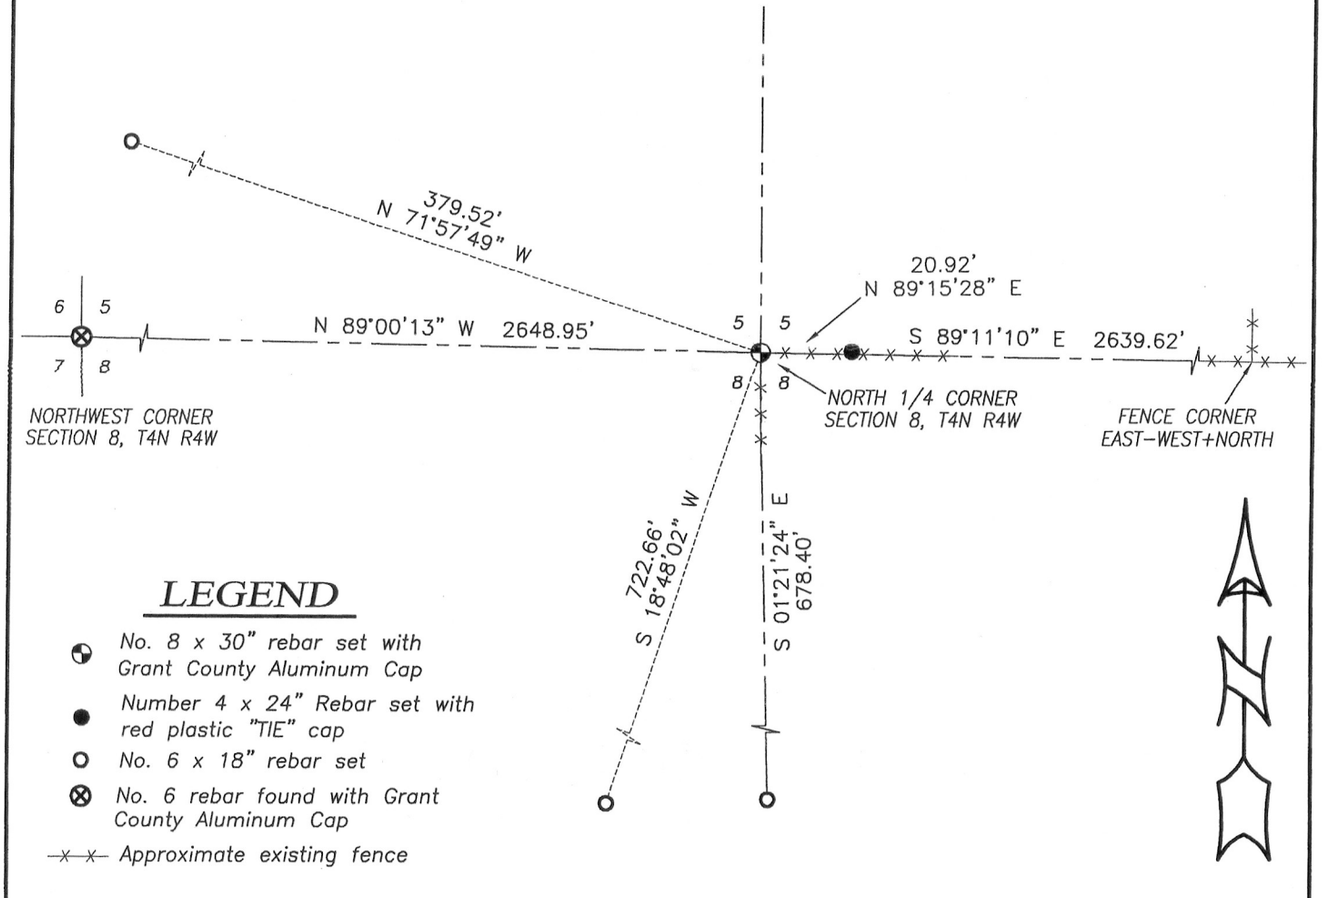

LEGEND

- No. 8 x 30" rebar set with Grant County Aluminum Cap
- Number 4 x 24" Rebar set with red plastic "TIE" cap
- No. 6 x 18" rebar set
- No. 6 rebar found with Grant County Aluminum Cap
- Approximate existing fence

SKETCH NOT TO SCALE

Austin Engineering LLC
austinengineeringllc.com
4211 HWY 81 E, LANCASTER, WI 53813
PHONE: 608-723-6363 FAX: 608-723-6702

JOB NO: 11s195
G:\T4NR4W\05
H:\TIE\T4NR4W\30

FIELDBOOK: TDSR
DRAWN BY: AJ AUSTIN
CREW: BS-SB

30

MAY 31 2012