


Survey Monument Record

TYPE OF MONUMENT ANGLE IRON  
FENCE POST IN CONC.

CORNER NO. 122  
 SECTION 36  
 TOWN 4N  
 RANGE 4W

FIELD BOOK: 96-19  
 PAGE (29)

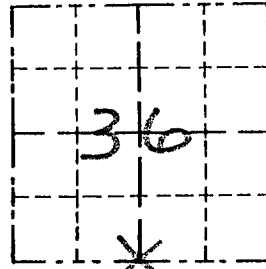

LOCATION  
 (Indicated by "X")


BASIS FOR MONUMENT LOCATION

(Use reverse side if necessary)

Show info such as: History of corner, with reference to Vol. and pg., dates, surveyor; exact description of monument replaced; if location computed, by taped or EDM traverse; landowner, remarks, etc.

SEAL:

CORNER SET IN 1832 BY SIBLEY. NO RECORD OF CORNER FOUND SINCE ORIGINAL SURVEYS; I ACCEPTED THE OCCUPATIONAL EVIDENCE AS THE CORNER LOCATION. VERIFIED THIS LOCATION BY EDM TRAVERSE OF THE AREA.

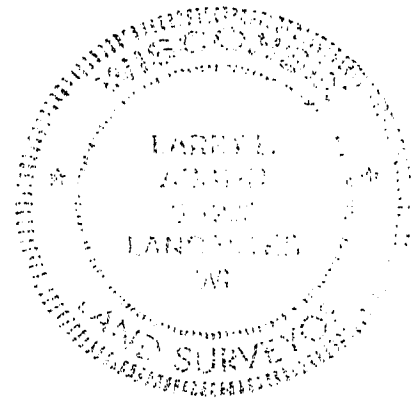

CERTIFIED CORRECT

*Terry L. Adams*  
 Registered Land Surveyor

DATE: 1/12/96

TIE SKETCH

Show at least three (3) ties and monument

LEGEND

- ⊕ ANGLE IRON FENCE POST SET IN CONC.
- 1/2" x 15" IRON BAR SET
- EXISTING FENCE

