U.S. PUBLIC LAND SURVEY MONUMENT RECORD – GRANT COUNTY, WI

Section 10, Town 4 North Range 6 West, Town of Glen Haven

CERTIFICATE

I, Larry L. Austin, do hereby certify that the corner location on this record was determined by me and/or under my direct supervision and that this U.S. public land survey monument record is correct and complete to the best of my knowledge and belief.

Larry L. Austin 2-25-07

Larry L. Austin, S–1903 date

WISCONSIN LARRY L. AUSTIN S-1903 LANCASTER WI LAND SURVEYOR

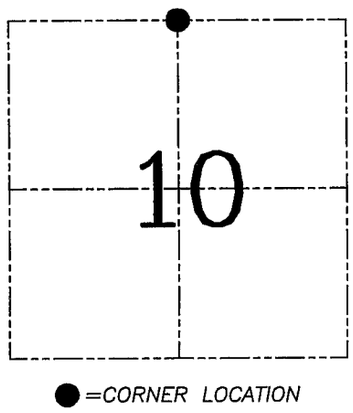

HISTORY OF CORNER ESTABLISHMENT

Corner was originally set in 1832 by Robert Clark. In 1858 Hayden tied to the corner with no mention of monument. In 1962 Kenneth Cullen tied to the corner. No other record of the corner was found.

DESCRIPTION OF CORNER EVIDENCE FOUND

I established the corner location based on Cullen's concrete monuments in the area of the corner. Verified this location using EDM & GPS methods.

DESCRIPTION OF CORNER AND WITNESS MONUMENTS, references and accessories used to perpetuate the original or re–established location of this corner. Witnesses to corner location Bobby Sedgwick & Brad Digman & Shelby Blindert

SKETCH:

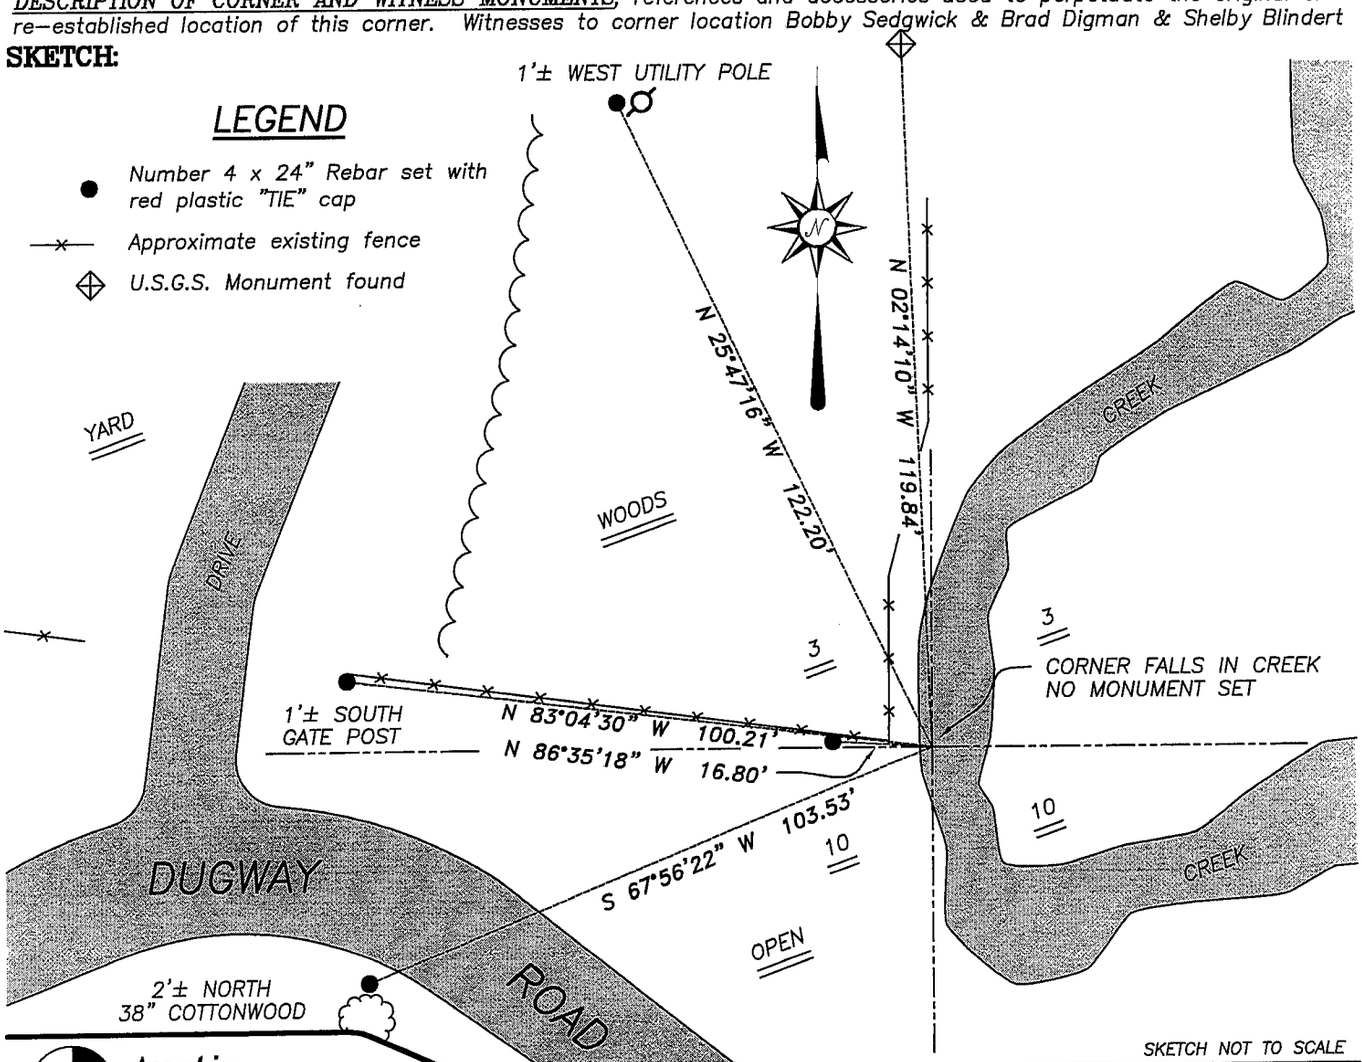

Austin Engineering LLC
4211 HWY 81 E, LANCASTER, WI 53813
PHONE 608–723–6363 FAX 608–723–6702

JOB NUMBER 05S340
FIELDBOOK: TDSR, 2601
G:\T4NR6W\10
H:\TIE\T4NR6W\26

DRAWN BY: SW AUSTIN
APPROVED: LL AUSTIN