U.S. PUBLIC LAND SURVEY MONUMENT RECORD – GRANT COUNTY, WI

Section 18, Town 5 North Range 2 West, Town of Liberty

CERTIFICATE

I, Larry L. Austin, do hereby certify that the corner location on this record was determined by me and/or under my direct supervision and that this U.S. public land survey monument record is correct and complete to the best of my knowledge and belief.

Dated this 27th day of May, 2003.

Larry L. Austin S–1903

WISCONSIN LARRY L. AUSTIN S-1903 LANCASTER WI LAND SURVEYOR

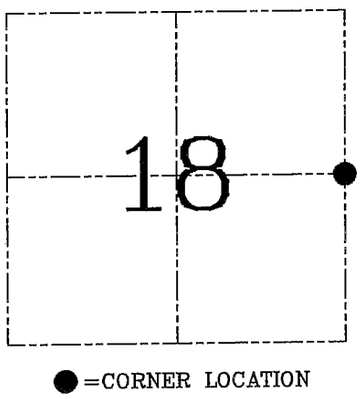

HISTORY OF CORNER ESTABLISHMENT

Corner was originally set in 1832 by Harvey Parke. Joel Barber reset the corner while surveying in Section 18. No other record of the corner was found.

DESCRIPTION OF CORNER EVIDENCE FOUND

I found an existing 1" iron pipe at this location.
I accepted it after an EDM & GPS traverse of the area.

DESCRIPTION OF CORNER AND WITNESS MONUMENTS, references and accessories used to perpetuate the original or re–established location of this corner. Witnesses to corner location Bobby Sedgwick & Shane Austin & Brad Digman

SKETCH:

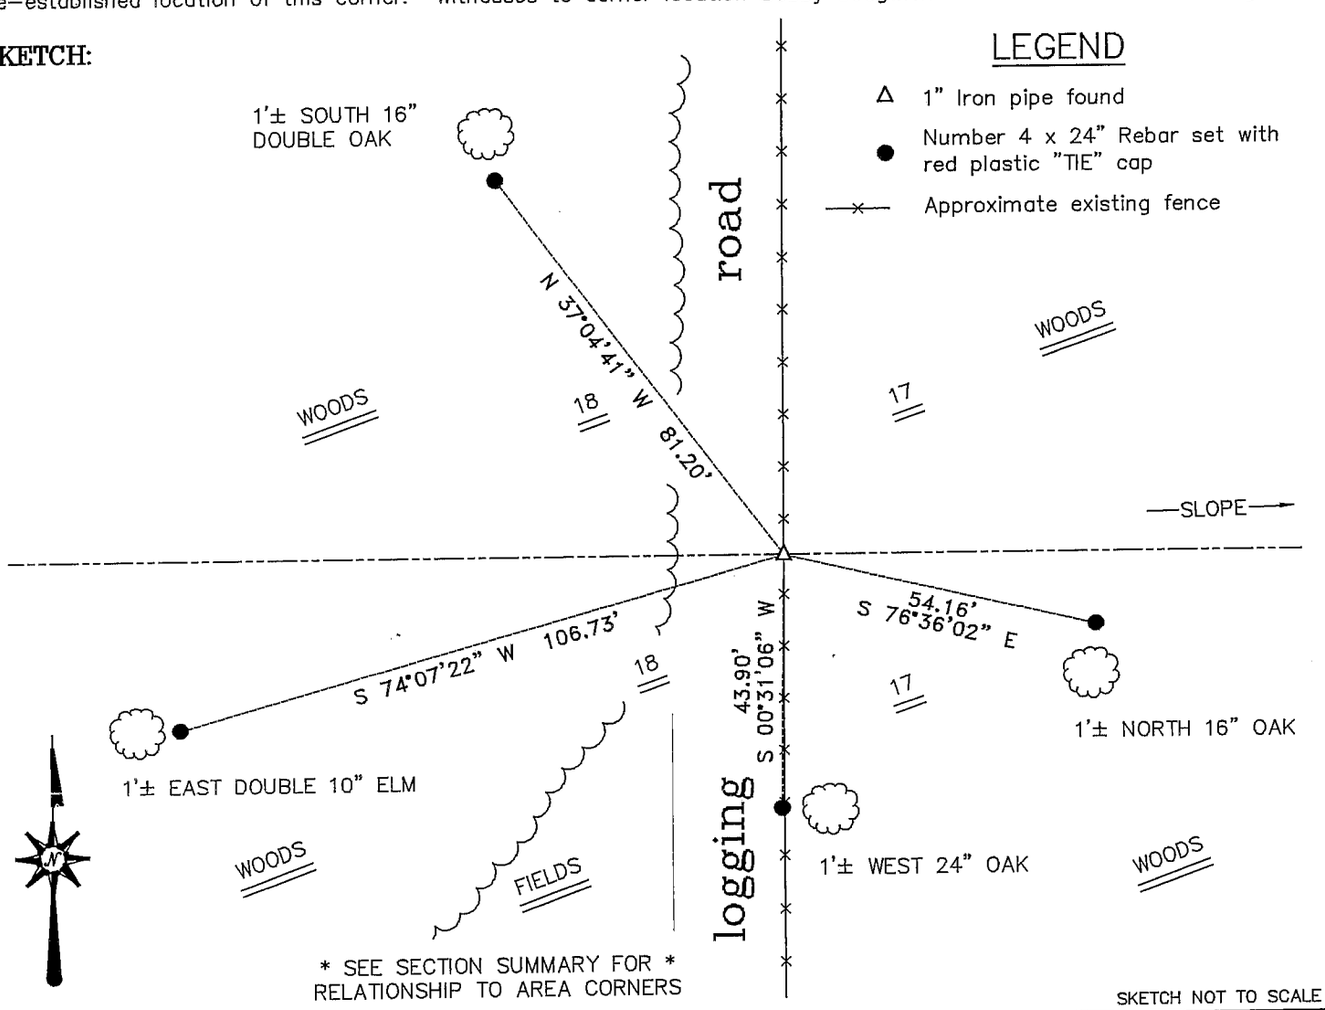

AUSTIN ENGINEERING, LLC
4211 HWY 81 EAST, LANCASTER, WI 53813
PHONE 608–723–6363 FAX 608–723–6702

FIELDBOOK: TDS RNGR, 94–00
G:\T5NR2W\19
H:\TIE\T5NR2W\55
JOB NUMBER 03S100

DRAWN BY: SW AUSTIN
APPROVED: LL AUSTIN

CORNER NUMBER 55