U.S. PUBLIC LAND SURVEY MONUMENT RECORD – GRANT COUNTY, WI

Section 4, Town 5 North Range 3 West, Town of North Lancaster

CERTIFICATE

I, Larry L. Austin, do hereby certify that the corner location on this record was determined by me and/or under my direct supervision and that this U.S. public land survey monument record is correct and complete to the best of my knowledge and belief.

Larry L. Austin, S–1903

WISCONSIN LARRY L. AUSTIN date S-1903 LANCASTER WI LAND SURVEYOR

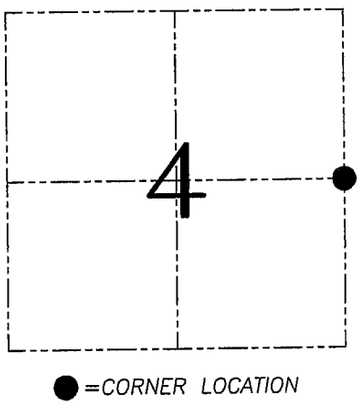

HISTORY OF CORNER ESTABLISHMENT

Corner was originally set in 1832 by Parke. In 1859 Blauding tied to the corner. No recent record of the corner was found.

DESCRIPTION OF CORNER EVIDENCE FOUND

I found an existing fence corner and accepted it's location after an EDM & GPS traverse of the area.

DESCRIPTION OF CORNER AND WITNESS MONUMENTS, references and accessories used to perpetuate the original or re–established location of this corner. Witnesses to corner location Bobby Sedgwick & Brad Digman & Shane Austin

SKETCH:

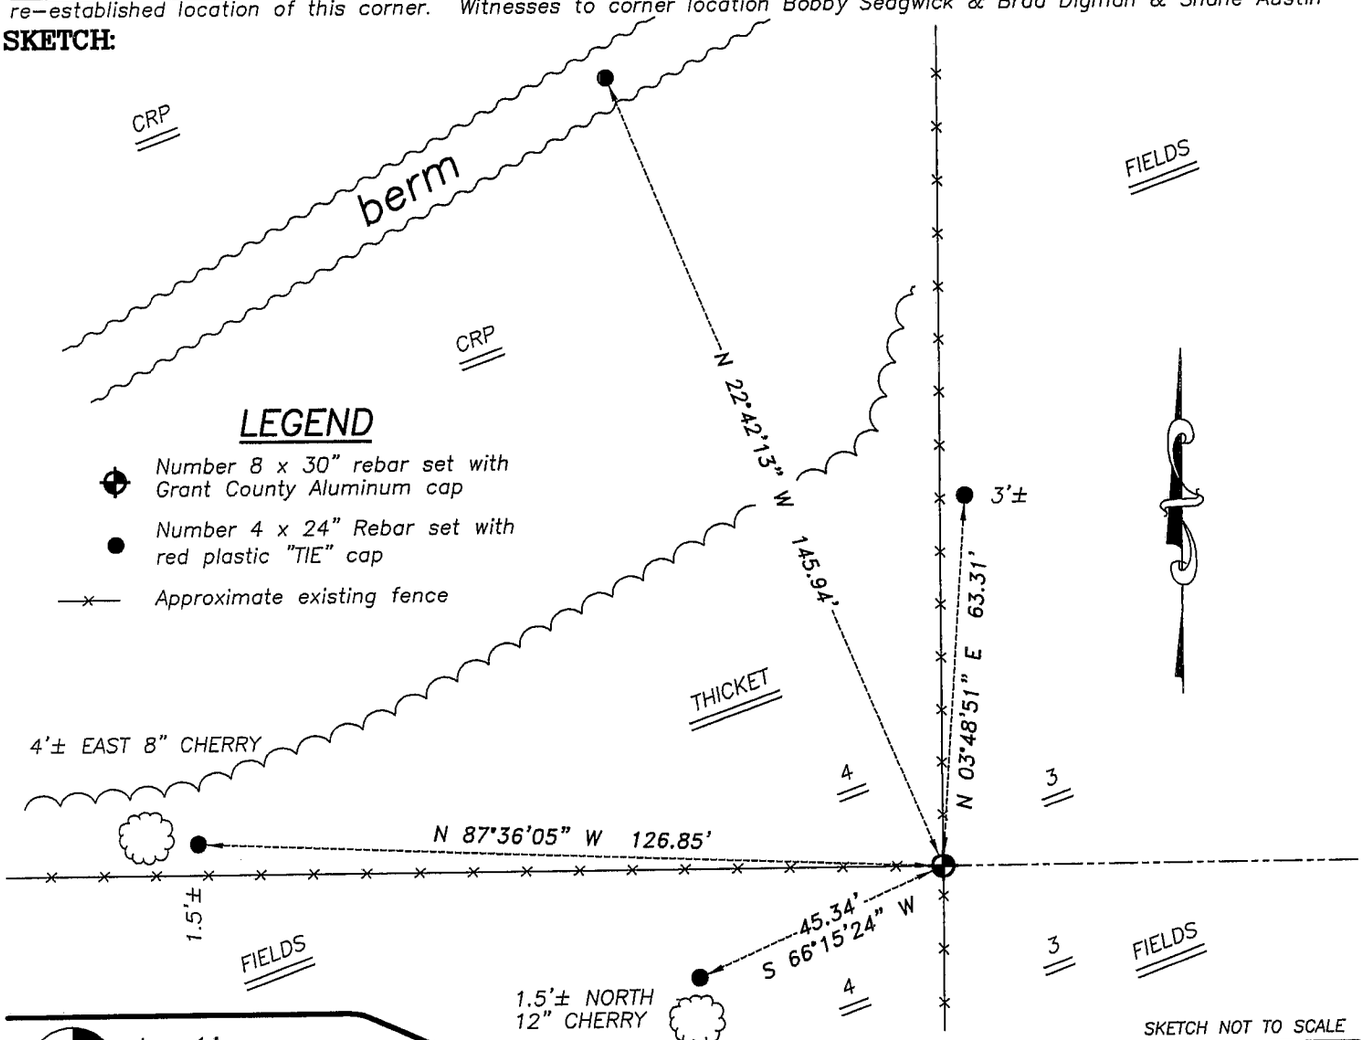

SKETCH NOT TO SCALE

Austin Engineering LLC
4211 HWY 81 E, LANCASTER, WI 53813
PHONE 608–723–6363 FAX 608–723–6702

JOB NUMBER 06S172
FIELDBOOK: TDSR, 2705
G:\T6NR3W\33A
H:\TIE\T5NR3W\17

DRAWN BY: SW AUSTIN
APPROVED: LL AUSTIN