U.S. PUBLIC LAND SURVEY MONUMENT RECORD - GRANT COUNTY, WI

Section 7, Town 5 North Range 3 West, Town of North Lancaster

CERTIFICATE

I, Larry L. Austin, do hereby certify that the corner location on this record was determined by me and/or under my direct supervision and that this U.S. public land survey monument record is correct and complete to the best of my knowledge and belief.

Dated this 16th day of January, 2002

Larry L. Austin S–1903

WISCONSIN LARRY L. AUSTIN S-1903 LANCASTER WI LAND SURVEYOR

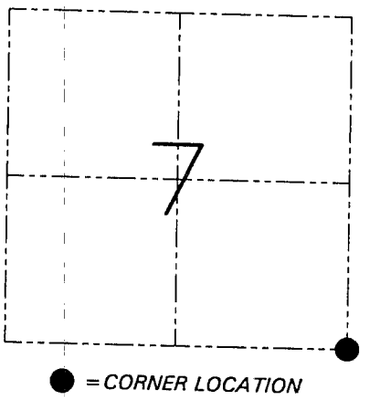

HISTORY OF CORNER ESTABLISHMENT

Corner was originally set in 1833 by Harvey Parke.
Various other surveys have been tied to this corner.

DESCRIPTION OF CORNER EVIDENCE FOUND

I found an existing 2" iron pipe post at an occupied location.
I accepted it's location after an EDM & GPS traverse of the area.

DESCRIPTION OF CORNER AND WITNESS MONUMENTS, *references and accessories used to perpetuate the original or re-established location of this corner. Witnesses to the corner location Bobby Sedgwick & Shelby Blindert & Kelly Wolf*

SKETCH:

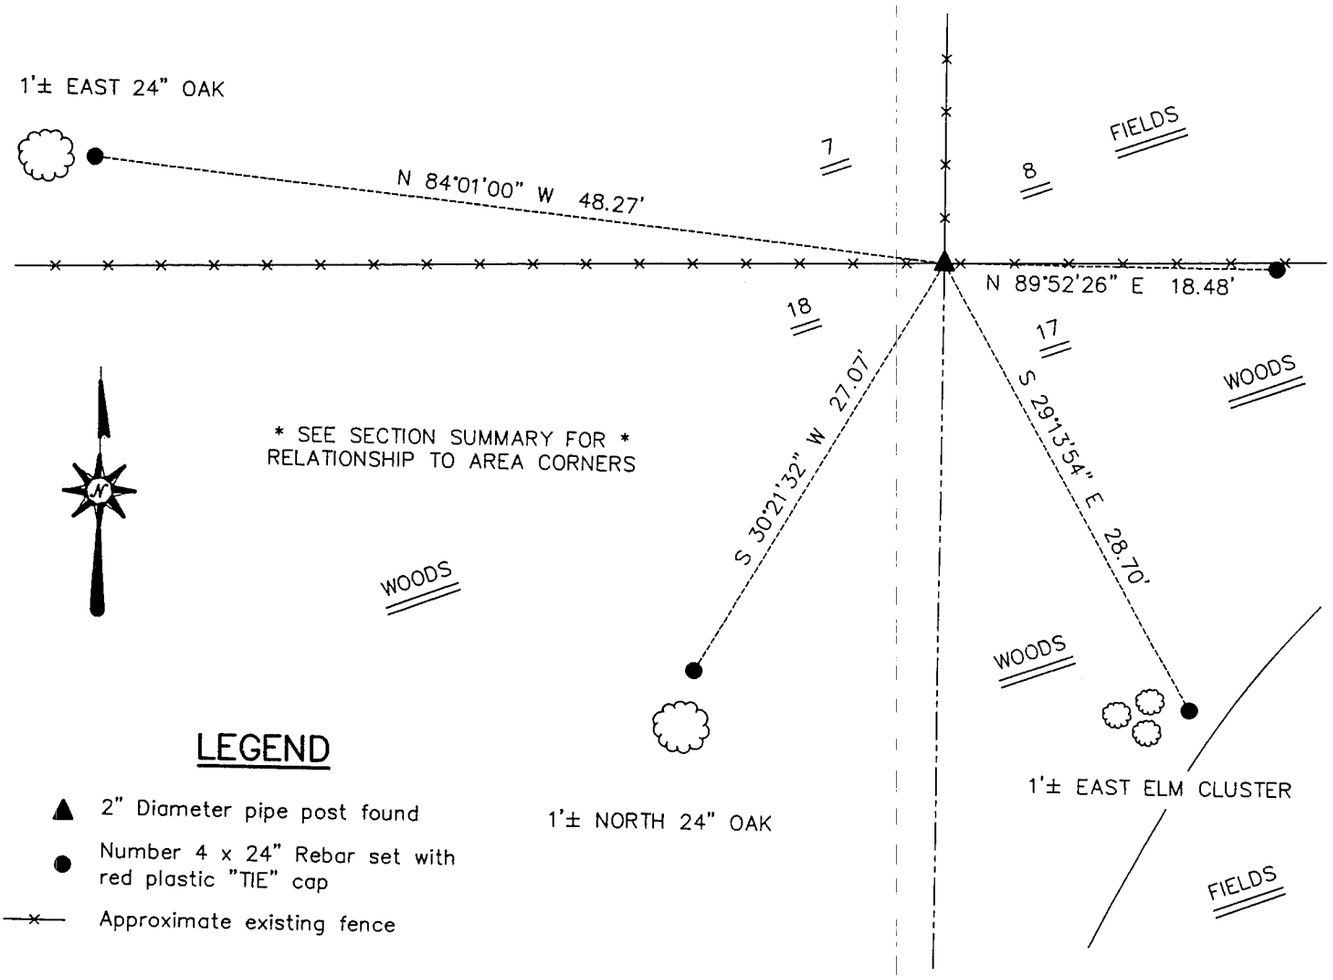

SKETCH NOT TO SCALE

AUSTIN ENGINEERING, LLC
4211 HWY 81 EAST, LANCASTER, WI 53813
PHONE 608–723–6363 FAX 608–723–6702

FIELDBOOK: SDR33, 2151
G:\T5NR3W\08
C:\SWA\TIE\T5NR3W\51
CREW: BS–SB–SA–KW

DRAWN BY: SW AUSTIN
APPROVED: LL AUSTIN

CORNER NUMBER 51